



TODD KNUTSON
DESIGN
WWW.TODDKNUTSONDESIGN.COM



5812 EXCELSIOR BLVD.
ST. LOUIS PK., MN. 55416
PHONE: 952-920-5555

TERMS:

CONTRACTOR TO VERIFY ALL DIMENSIONS, AS BUILT CONDITIONS (IF APPLY) AND SITE CONDITIONS, BEFORE ORDERING MATERIAL OR DEMOLISHING EXISTING STRUCTURES. CONTRACTOR AND ALL SUBS MUST REPORT ANY DISCREPANCIES TO DESIGNER IMMEDIATELY. AS BUILT AND SITE CONDITIONS OFTEN HAVE UNIQUE CONDITIONS THAT CANNOT BE PREDICTED OR FORSEEN AT DESIGN COMPLETION. CONTRACTOR, SUBS AND DESIGNER WILL WORK TOGETHER TO REACH A SOLUTION IF ANY SITUATION MAY ARISE.

BOYD REMODELING

10052 POWERS LAKE CIRCLE
WOODBURY, MN. 55129


JOB NO: 10052

SHEET NO:

A2

MAIN FLOOR

- 1
- 2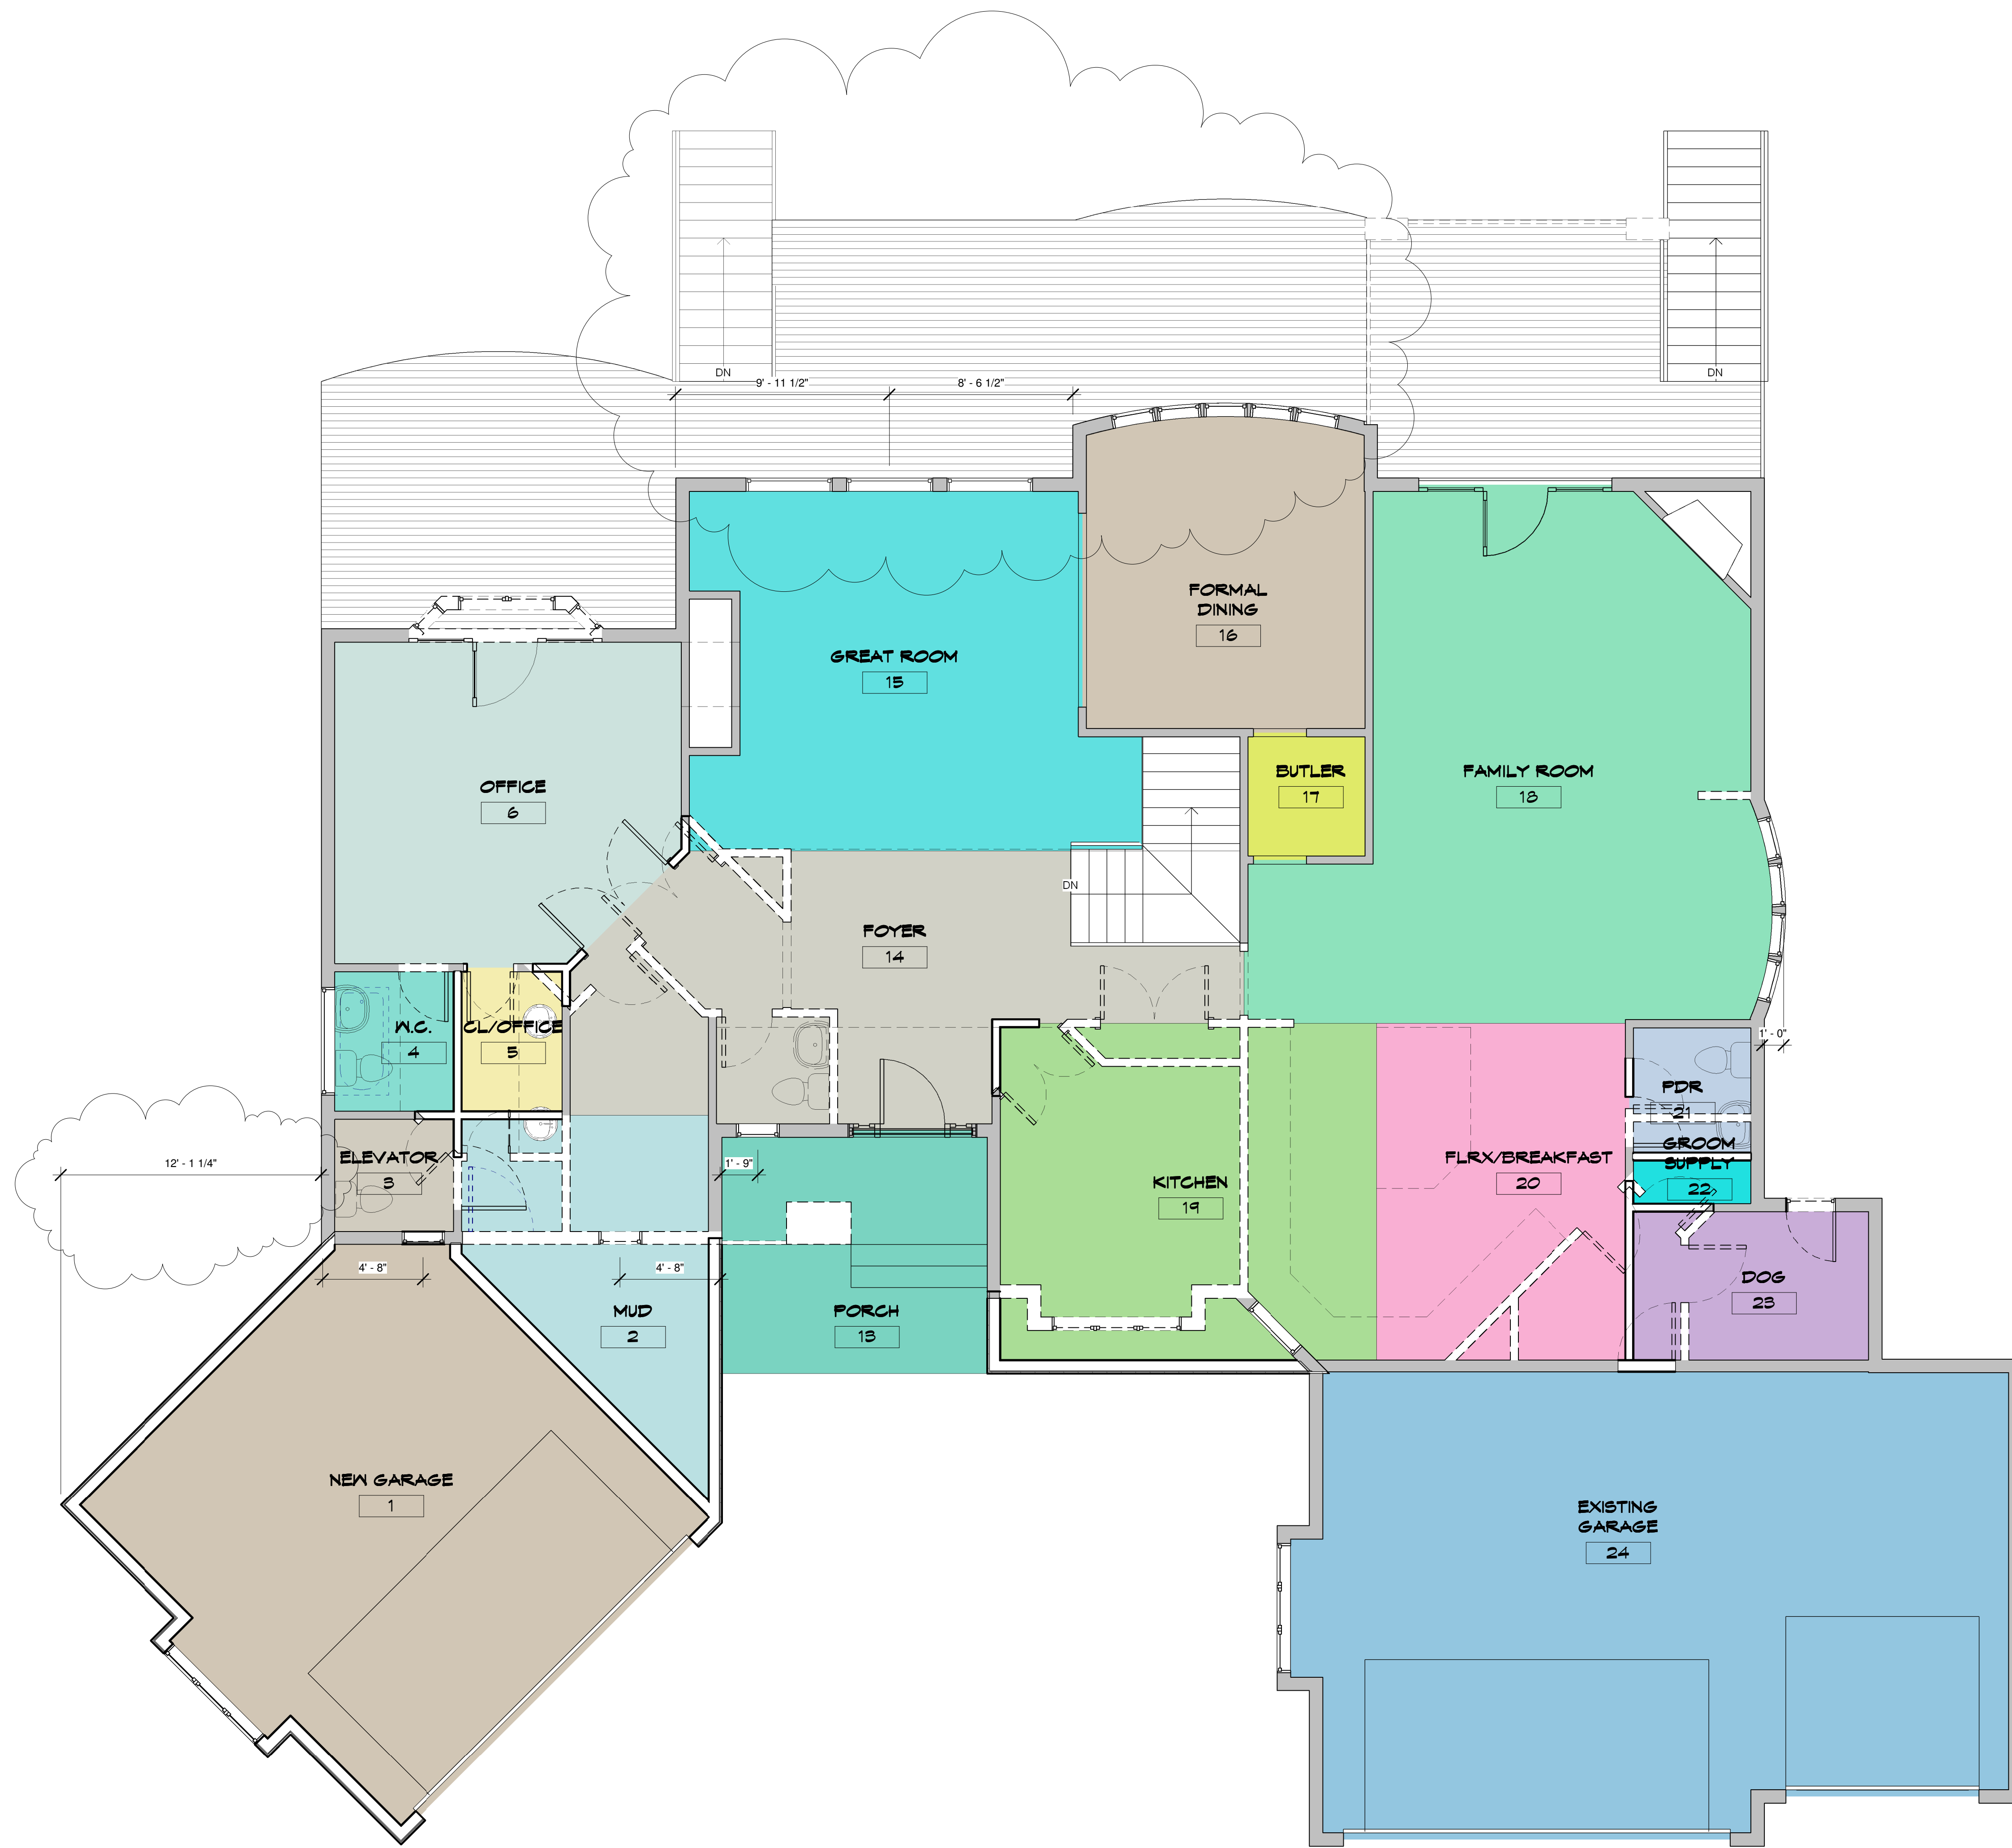
1 MAIN FLOOR
A2 1/4" = 1'-0"