


DATE: Issue Date

REVISIONS:

ISSUED FOR REVIEW  
2-14-08  
ISSUED FOR PERMIT  
3-31-08  
REVISED 4-20-08  
REVISED 5-5-08

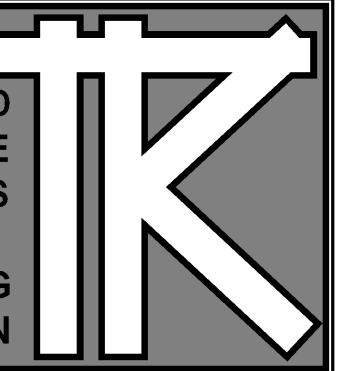

TODD KNUTSON  
DESIGN

530 NORTH 3RD ST.  
SUITE 530  
MINNEAPOLIS, MN. 55401  
PHONE 612-332-8000 X25  
FAX: 612-332-7504  
MOBIL: 612-251-1041

TERMS:

CONTRACTOR TO VERIFY ALL DIMENSIONS, AS BUILT CONDITIONS (IF APPLY) AND SITE CONDITIONS, BEFORE ORDERING MATERIAL OR DEMOLISHING EXISTING STRUCTURES. CONTRACTOR AND ALL SUBS MUST REPORT ANY DISCREPANCIES TO DESIGNER IMMEDIATELY. AS BUILT AND SITE CONDITIONS OFTEN HAVE UNIQUE CONDITIONS THAT CANNOT BE PREDICTED OR FORSEEN AT DESIGN COMPLETION. CONTRACTOR, SUBS AND DESIGNER WILL WORK TOGETHER TO REACH A SOLUTION IF ANY SITUATION MAY ARISE.

KAHMEYER RESIDENCE



Enter address here

JOB NO: 2007

SHEET NO:

**A0**

FOOTING PLAN

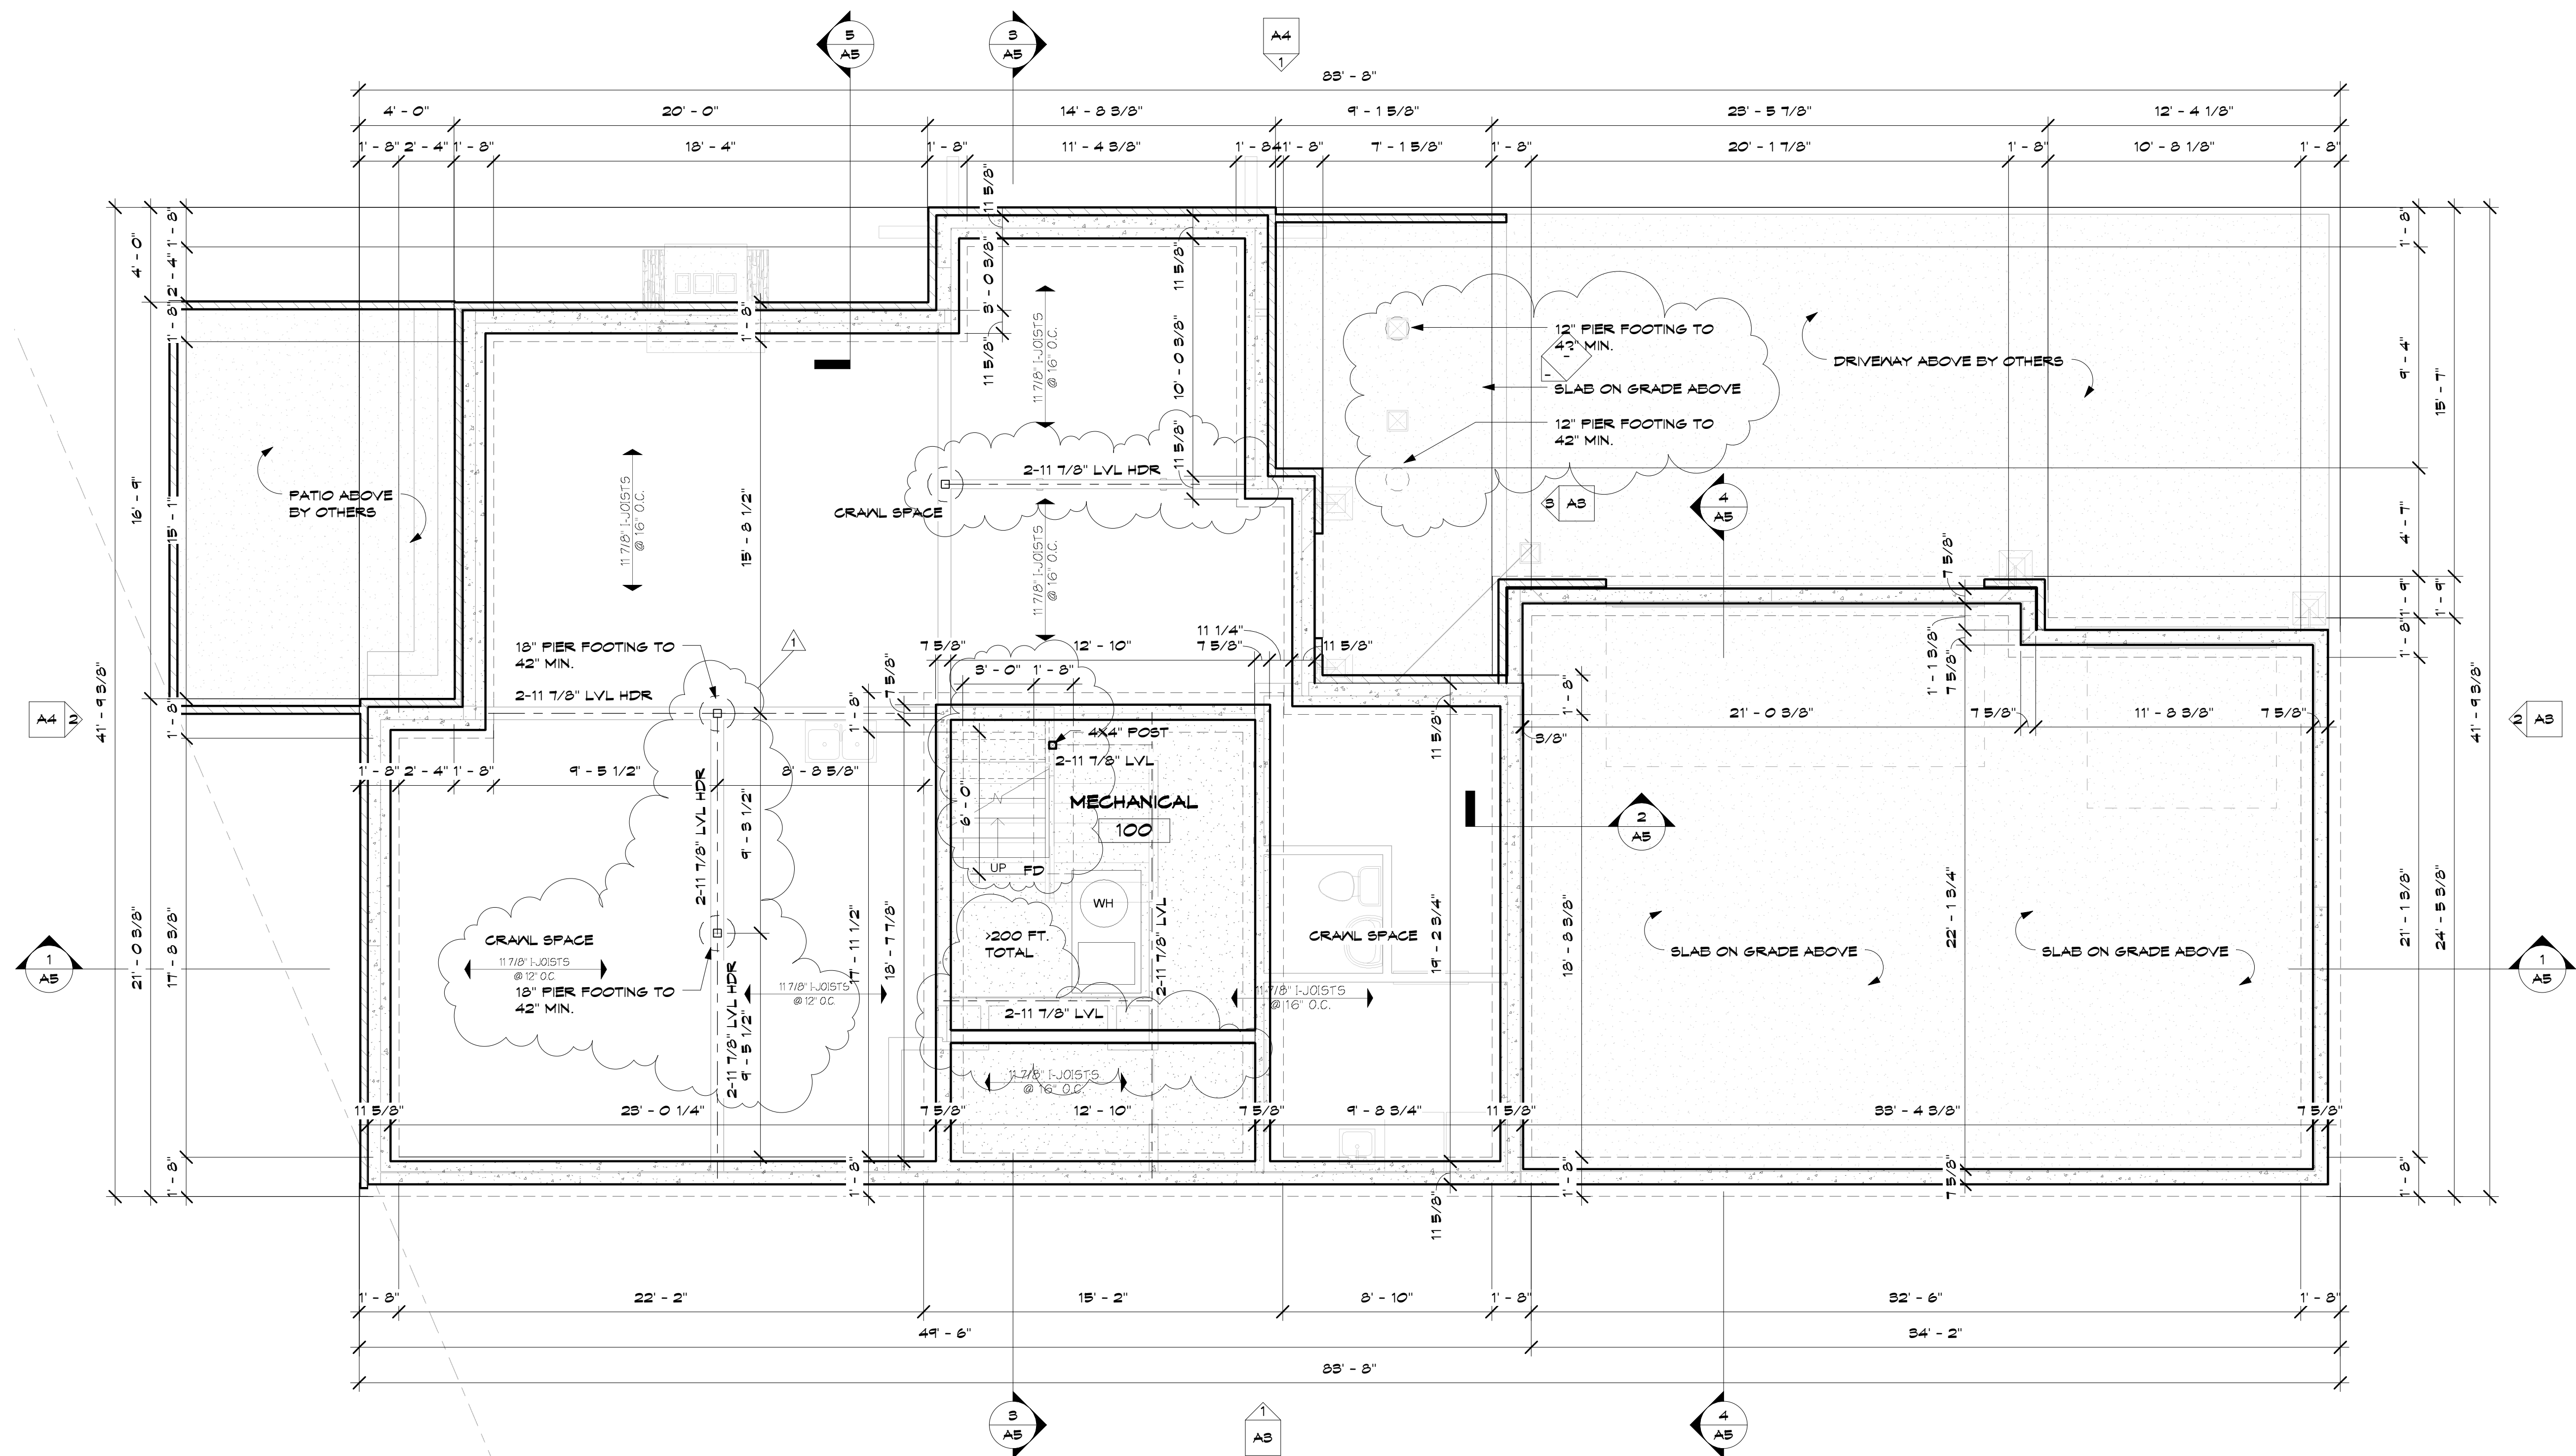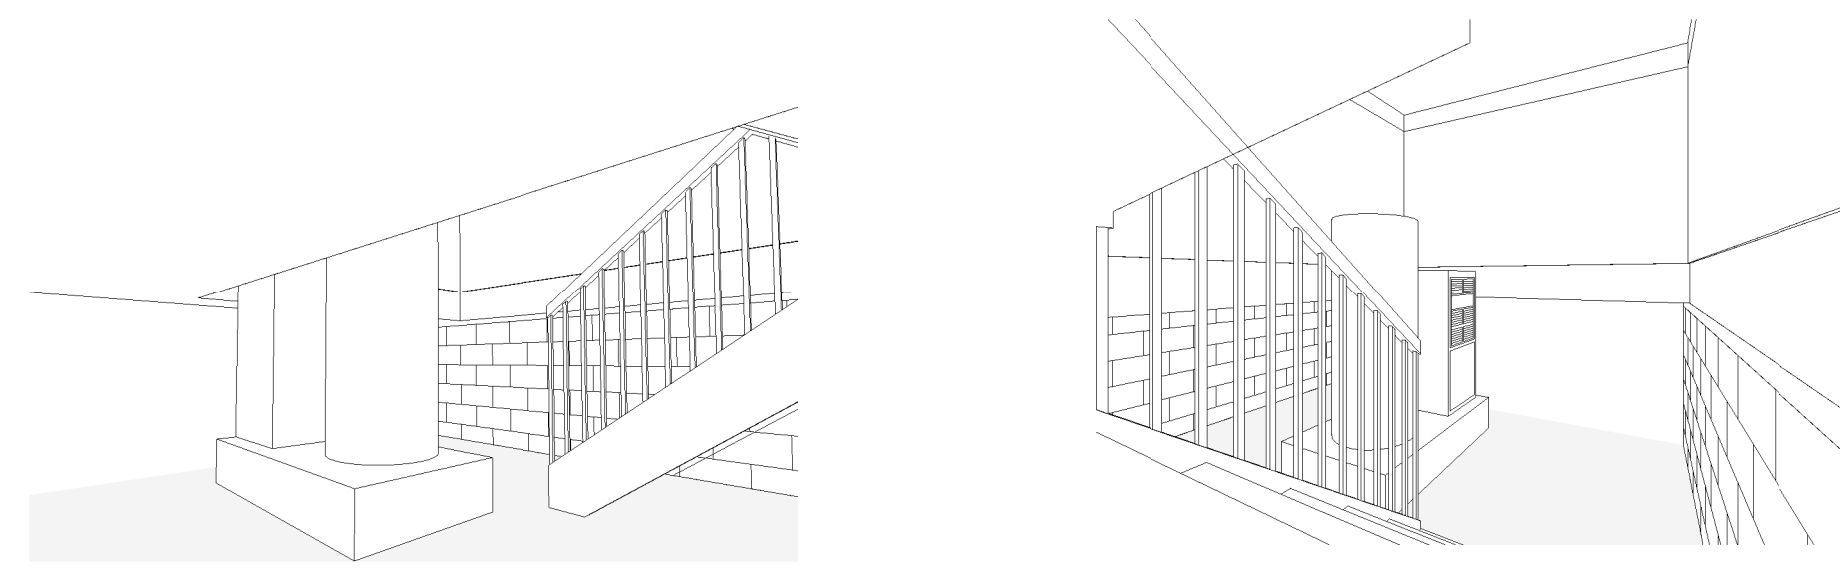


1 TOP OF FOOTING  
A0 1/4" = 1'-0"

DATE: Issue Date

REVISIONS:

ISSUED FOR REVIEW  
2-14-08  
ISSUED FOR PERMIT  
3-31-08  
REVISED 4-20-08  
REVISED 5-5-08

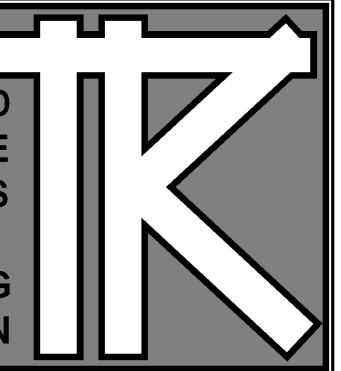

TODD KNUTSON  
DESIGN

530 NORTH 3RD ST.  
SUITE 530  
MINNEAPOLIS, MN, 55401  
PHONE 612-332-8000 X25  
FAX: 612-332-7504  
MOBIL: 612-251-1041

TERMS:

CONTRACTOR TO VERIFY ALL DIMENSIONS, AS BUILT CONDITIONS (IF APPLY) AND SITE CONDITIONS, BEFORE ORDERING MATERIAL OR DEMOLISHING EXISTING STRUCTURES. CONTRACTOR AND ALL SUBS MUST REPORT ANY DISCREPANCIES TO DESIGNER IMMEDIATELY. AS BUILT AND SITE CONDITIONS OFTEN HAVE UNIQUE CONDITIONS THAT CANNOT BE PREDICTED OR FORESEEN AT DESIGN COMPLETION. CONTRACTOR, SUBS AND DESIGNER WILL WORK TOGETHER TO REACH A SOLUTION IF ANY SITUATION MAY ARISE.

KAHMEYER RESIDENCE



Enter address here

JOB NO: 2007


SHEET NO:

**A1**


FLOOR PLAN

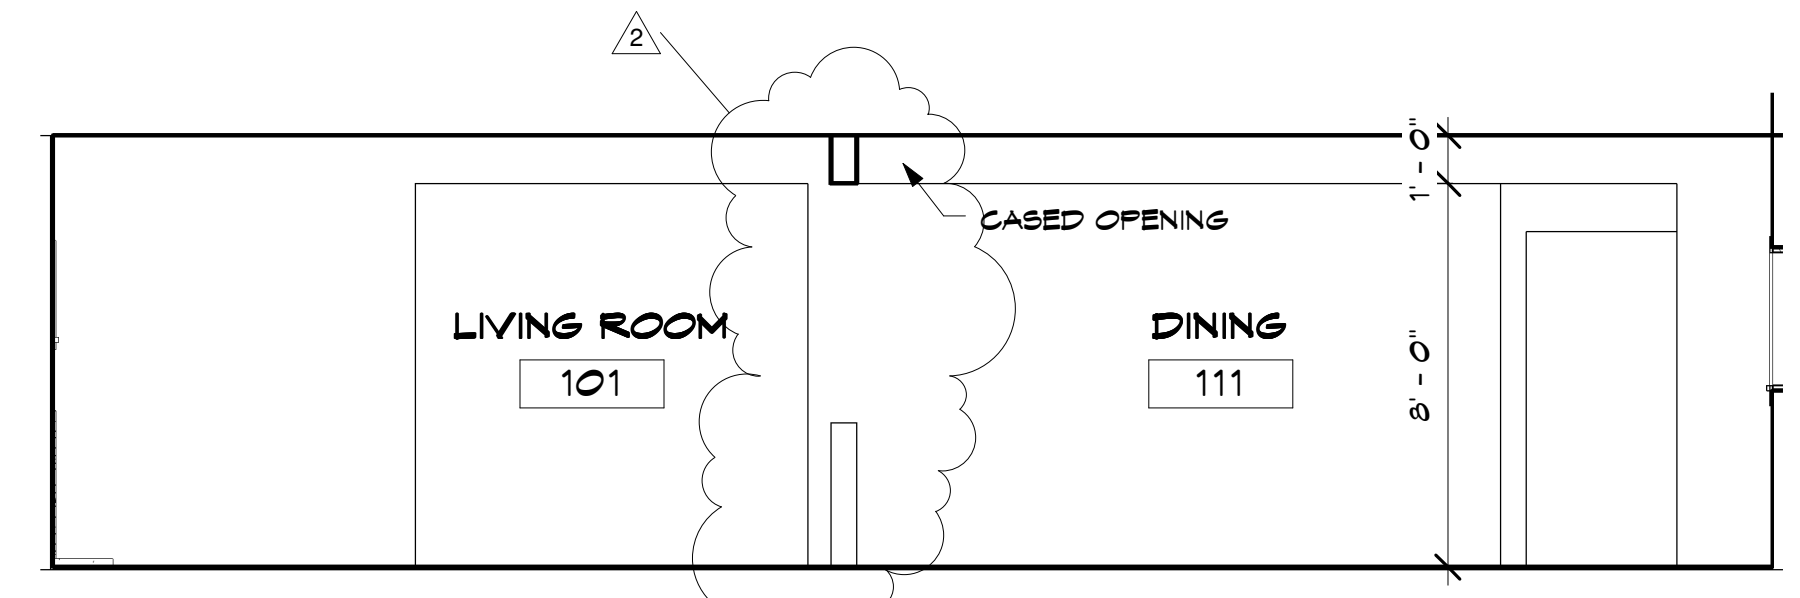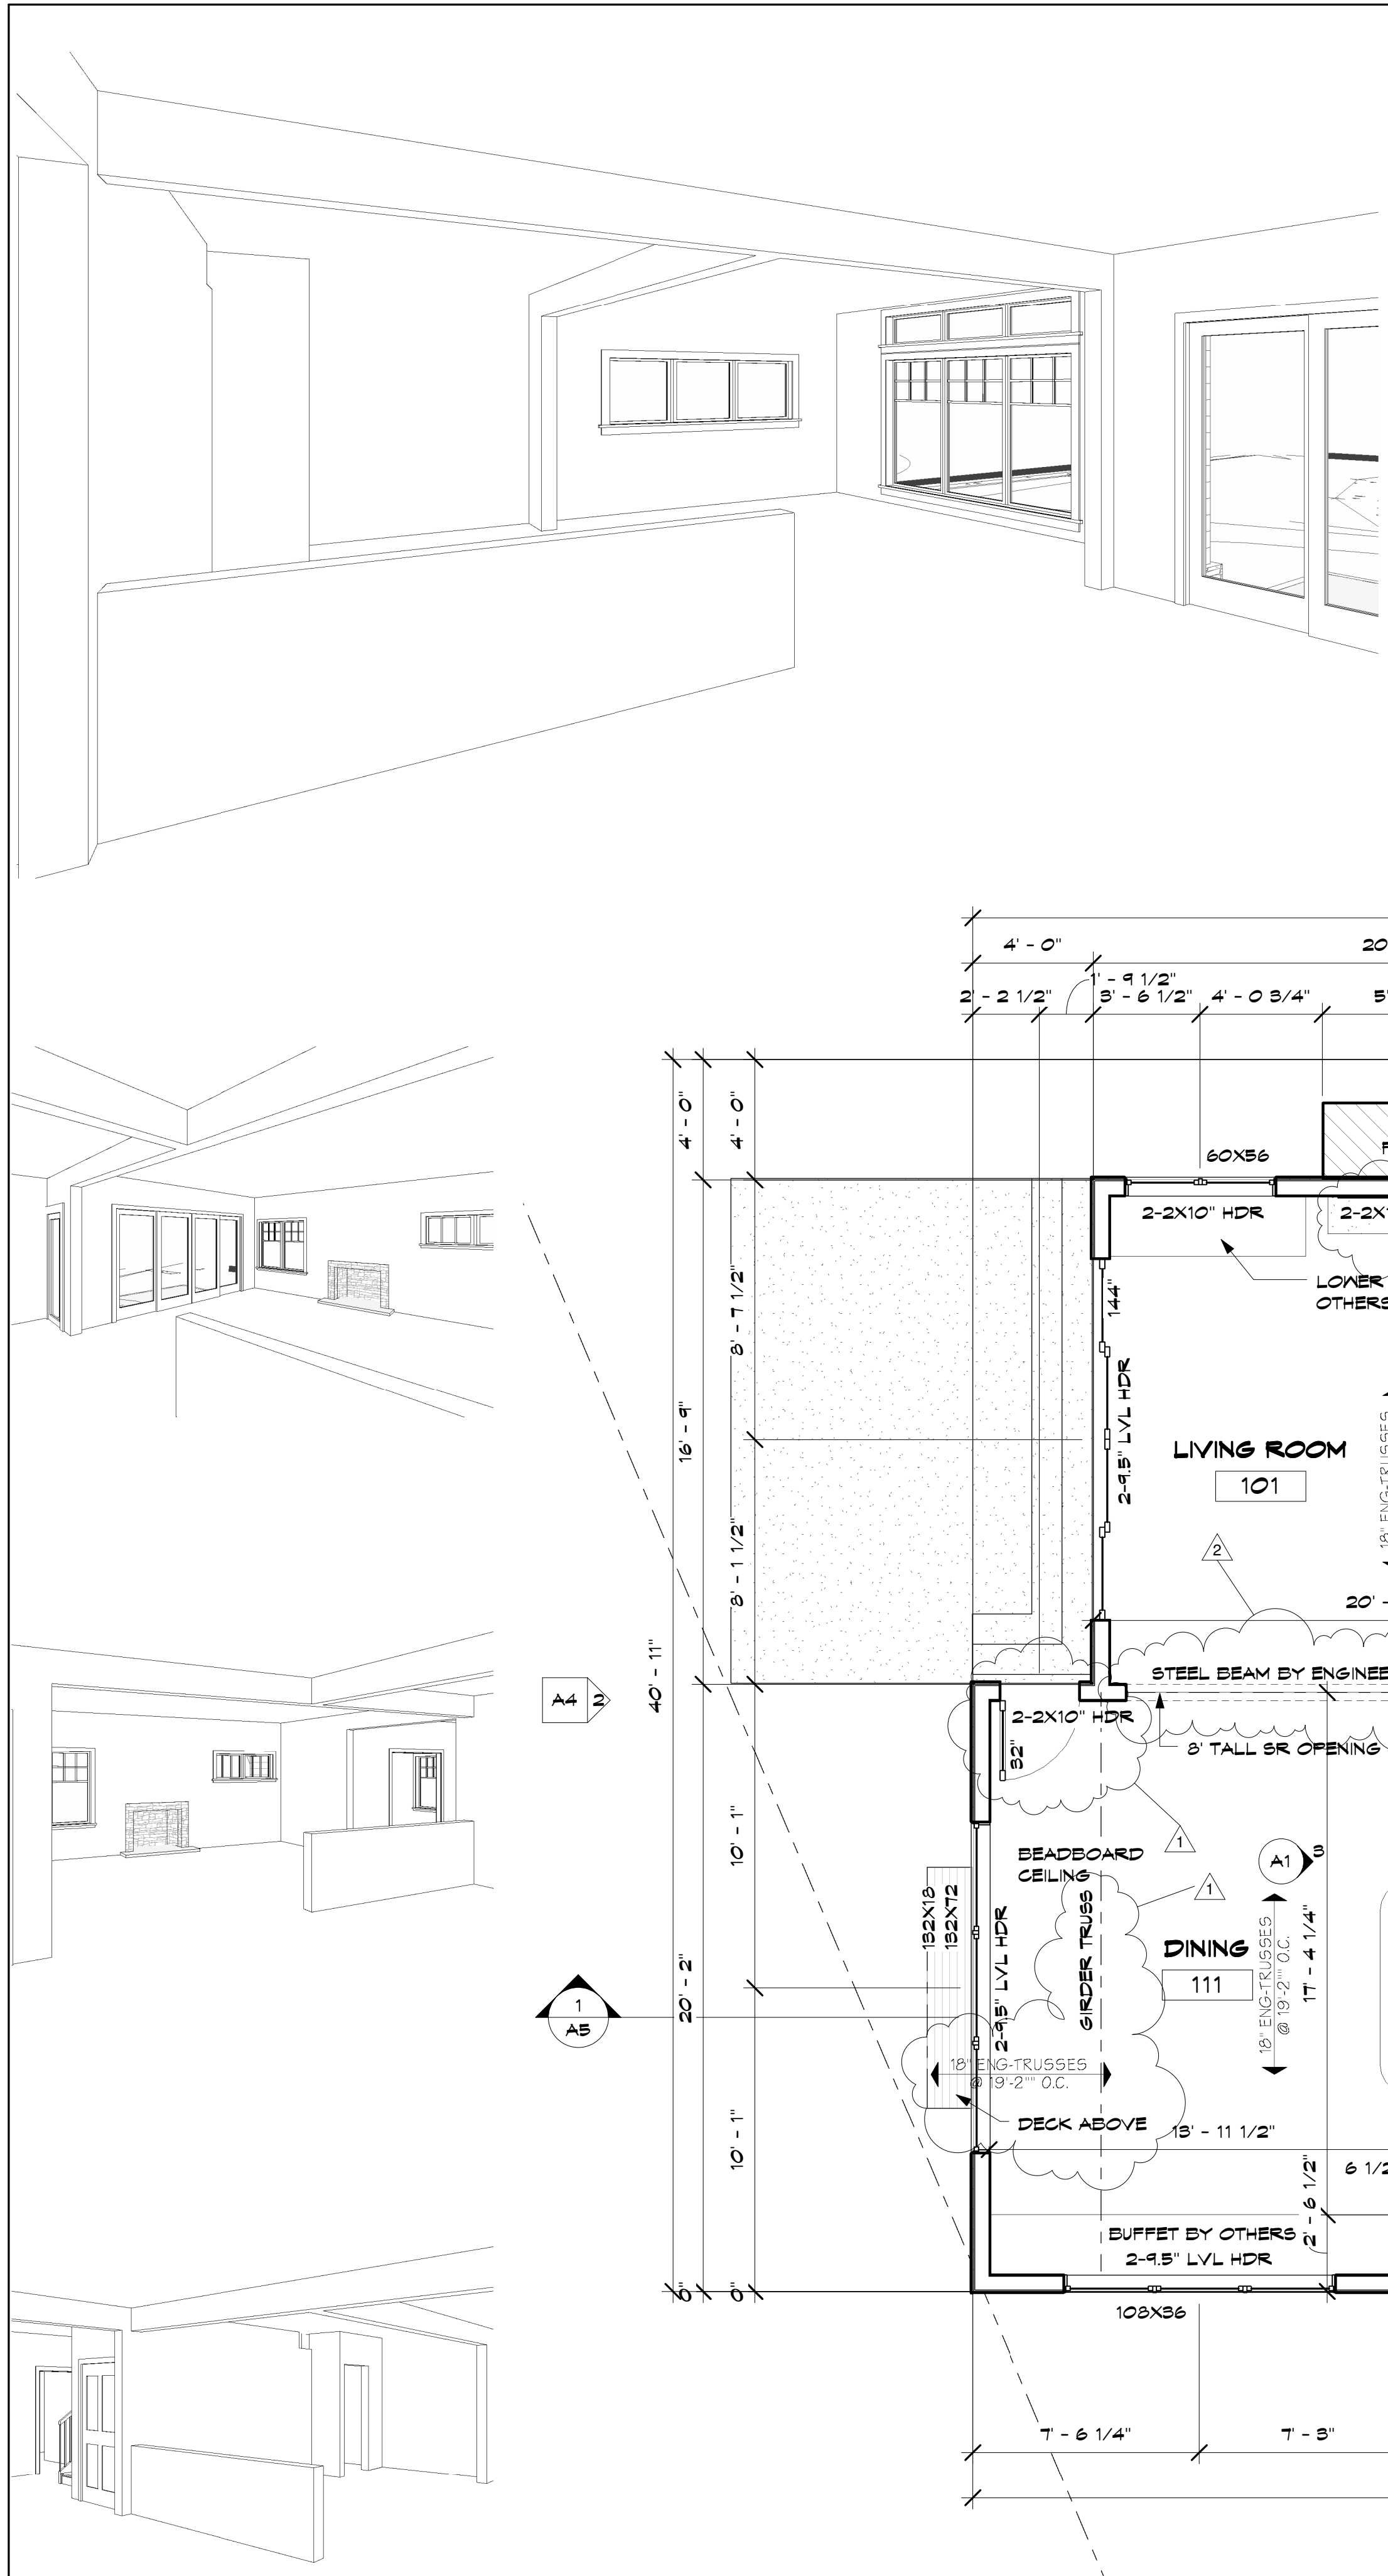

2 Elevation 2 - a  
A1 1/4" = 1'-0"

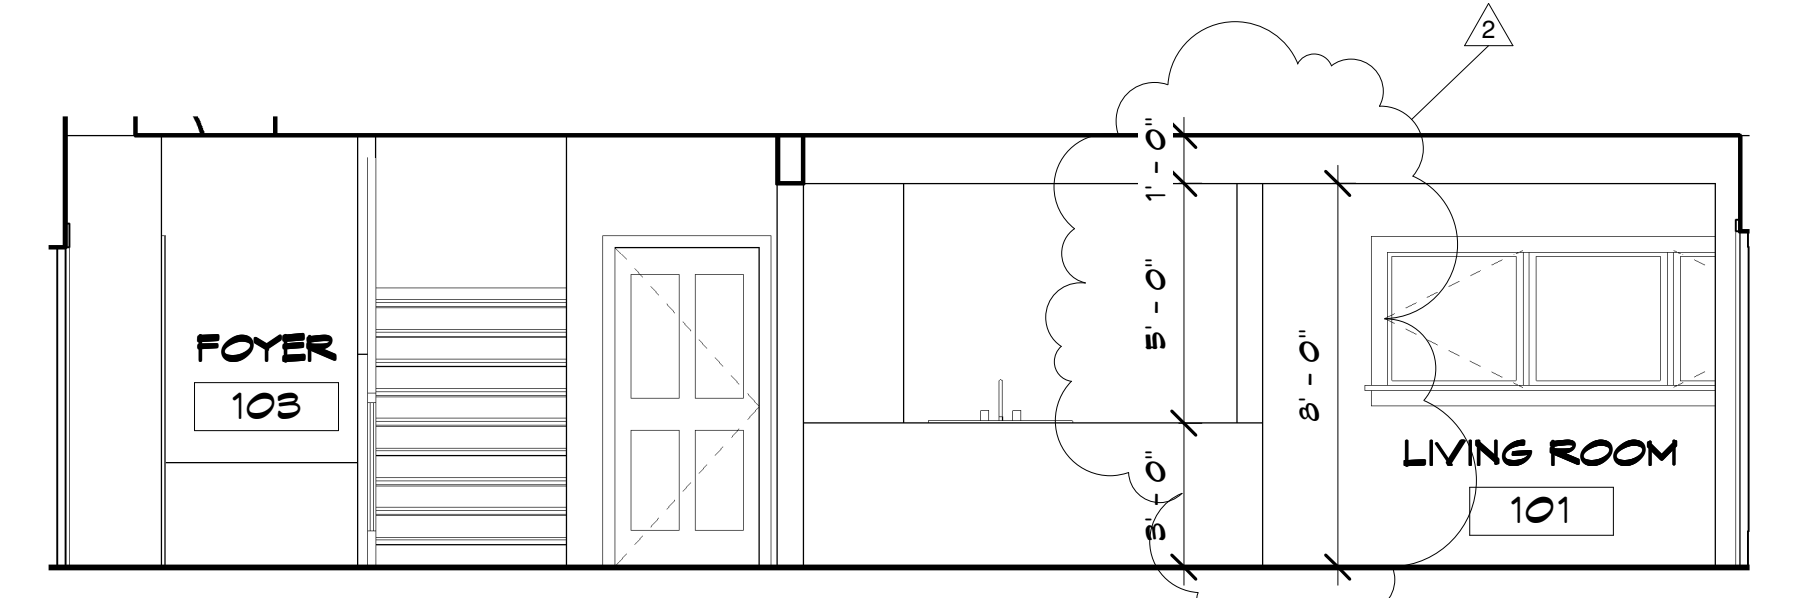

2 Elevation 1 - a  
A1 1/4" = 1'-0"

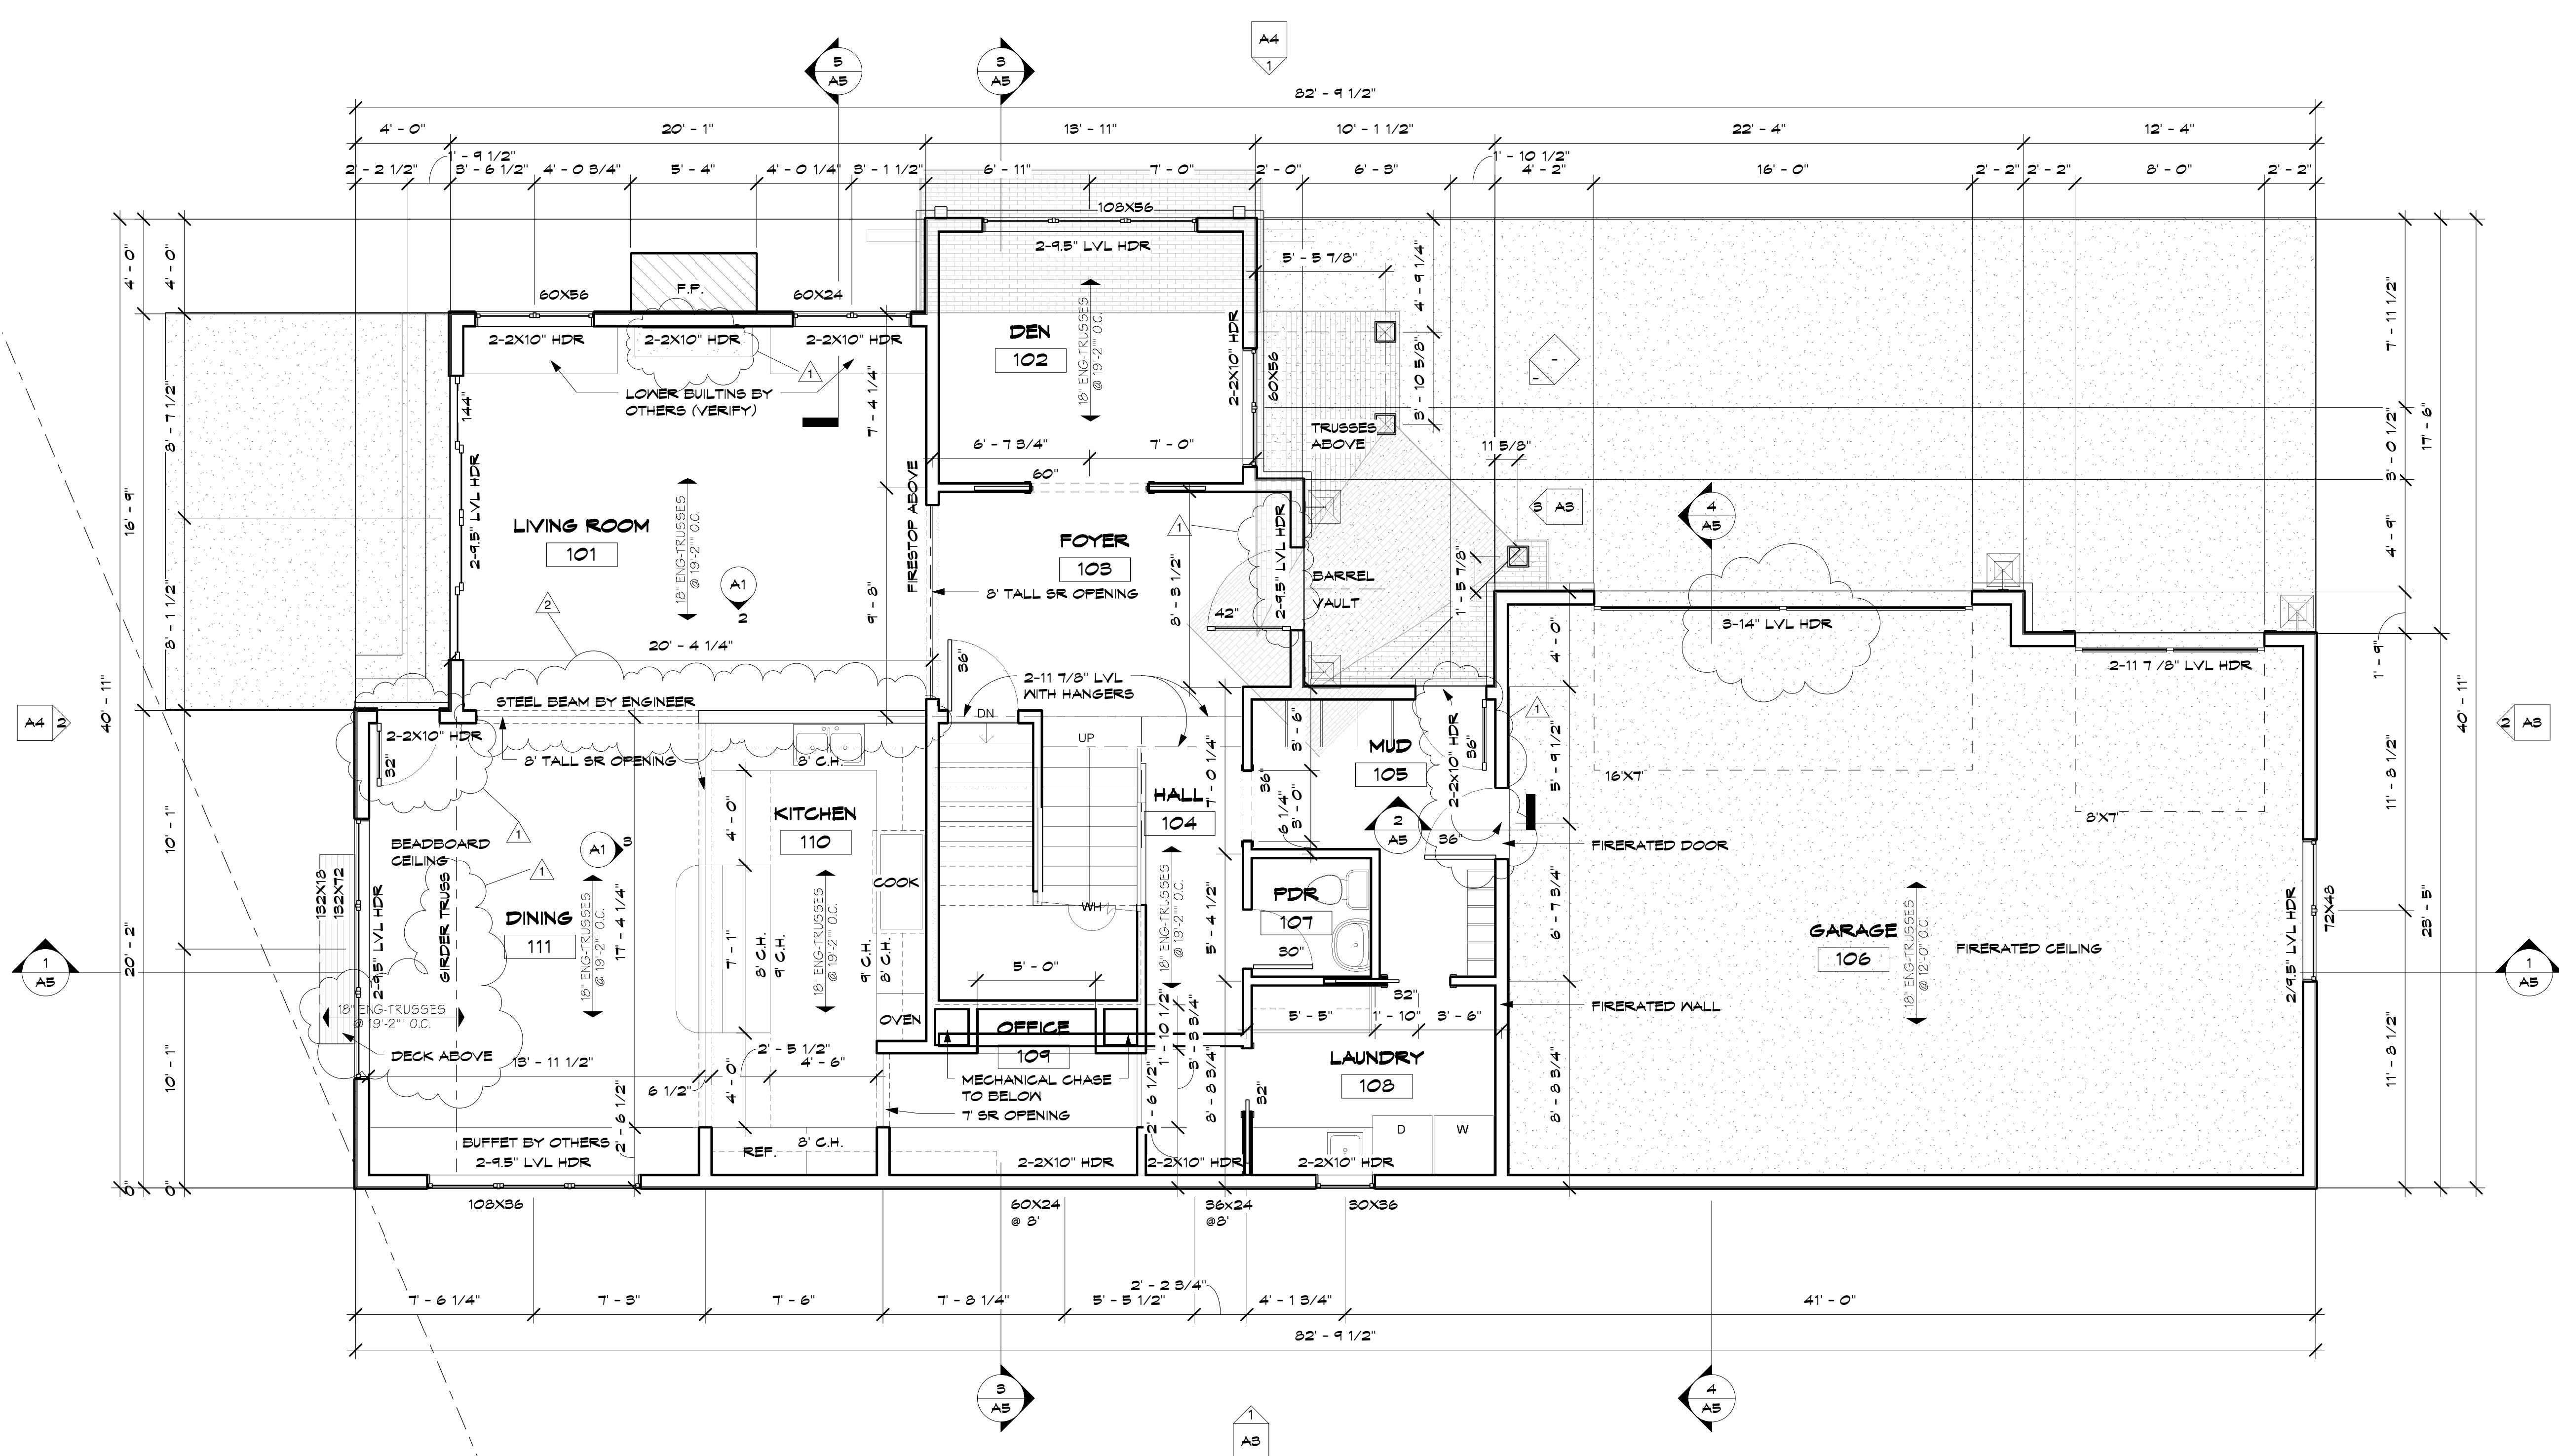


1 MAIN FLOOR  
A1 1/4" = 1'-0"

8/8/2008 10:38:49 AM

DATE: Issue Date

REVISIONS:

- ISSUED FOR REVIEW 2-14-08
- ISSUED FOR PERMIT 3-31-08
- REVISED 4-20-08
- REVISED 5-5-08

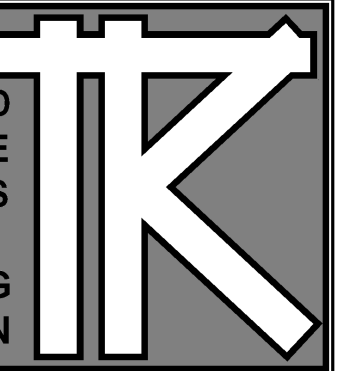

TODD KNUTSON  
DESIGN

530 NORTH 3RD ST.  
SUITE 530  
MINNEAPOLIS, MN. 55401  
PHONE 612-332-8000 X25  
FAX: 612-332-7504  
MOBIL: 612-251-1041

TERMS:

CONTRACTOR TO VERIFY ALL DIMENSIONS, AS BUILT CONDITIONS (IF APPLY) AND SITE CONDITIONS, BEFORE ORDERING MATERIAL OR DEMOLISHING EXISTING STRUCTURES. CONTRACTOR AND ALL SUBS MUST REPORT ANY DISCREPANCIES TO DESIGNER IMMEDIATELY. AS BUILT AND SITE CONDITIONS OFTEN HAVE UNIQUE CONDITIONS THAT CANNOT BE PREDICTED OR FORESEEN AT DESIGN COMPLETION. CONTRACTOR, SUBS AND DESIGNER WILL WORK TOGETHER TO REACH A SOLUTION IF ANY SITUATION MAY ARISE.

KAHMEYER RESIDENCE



Enter address here

JOB NO: 2007

SHEET NO:

**A2**

FLOOR PLAN

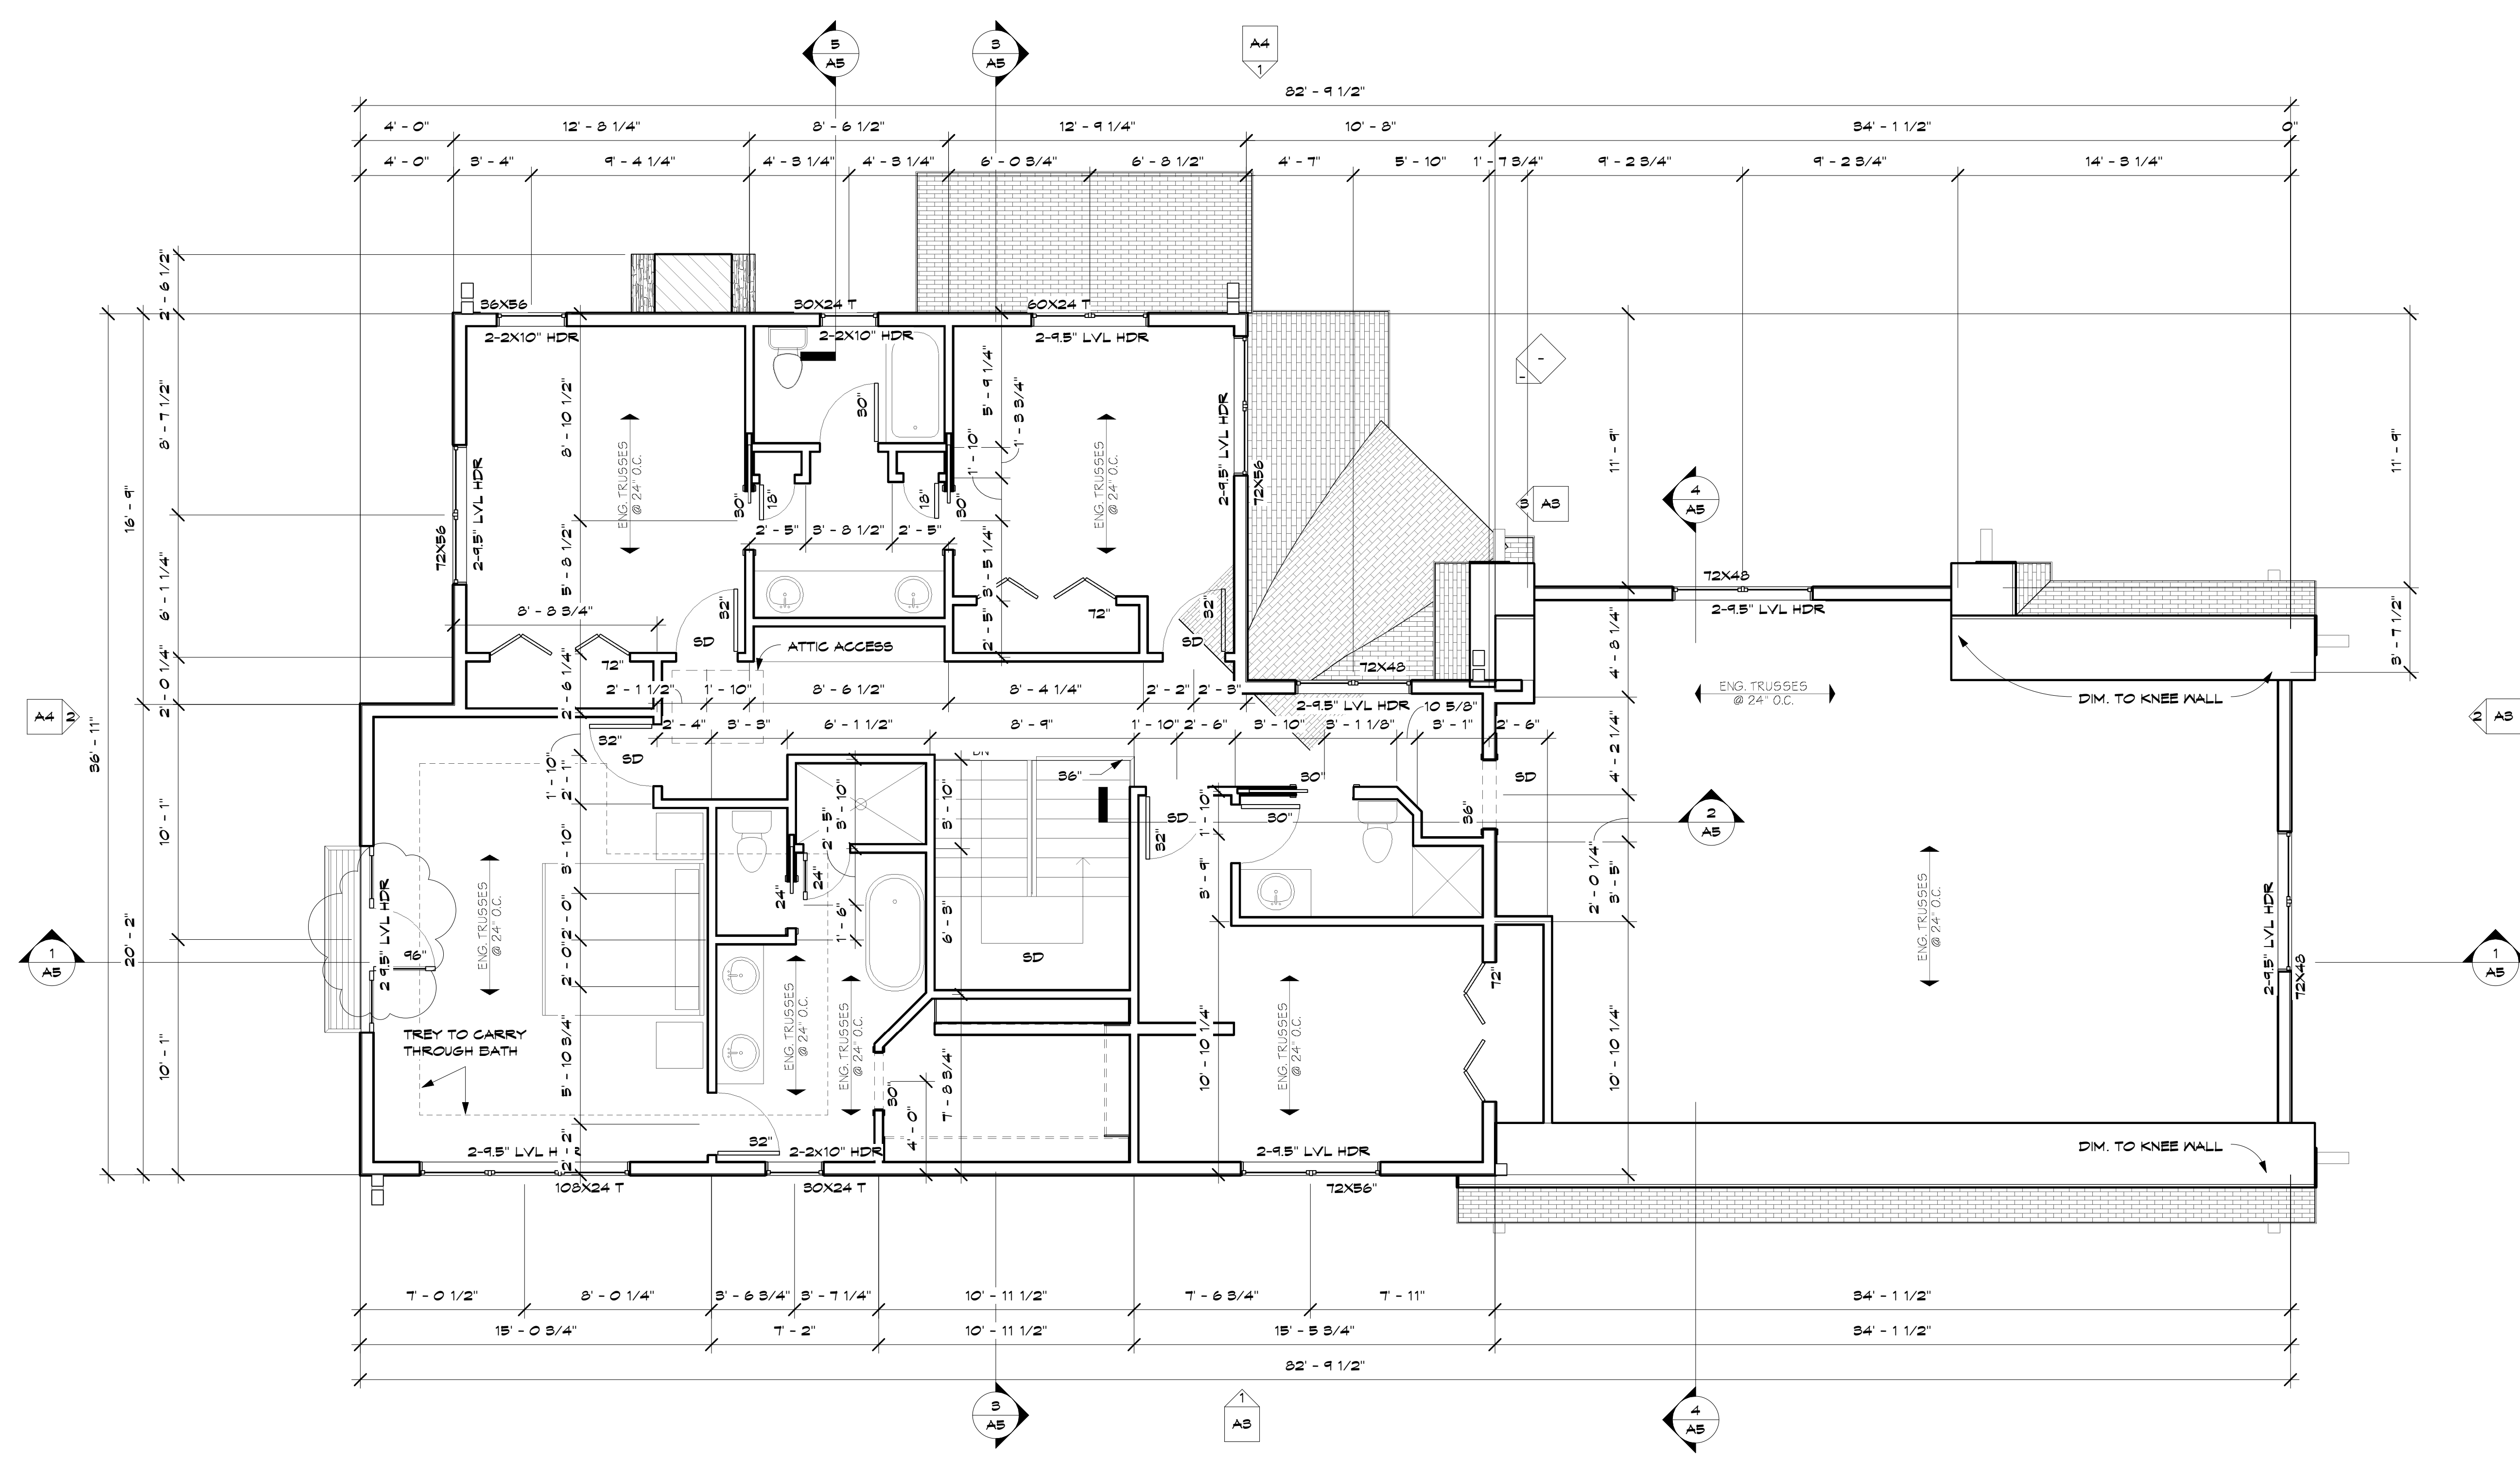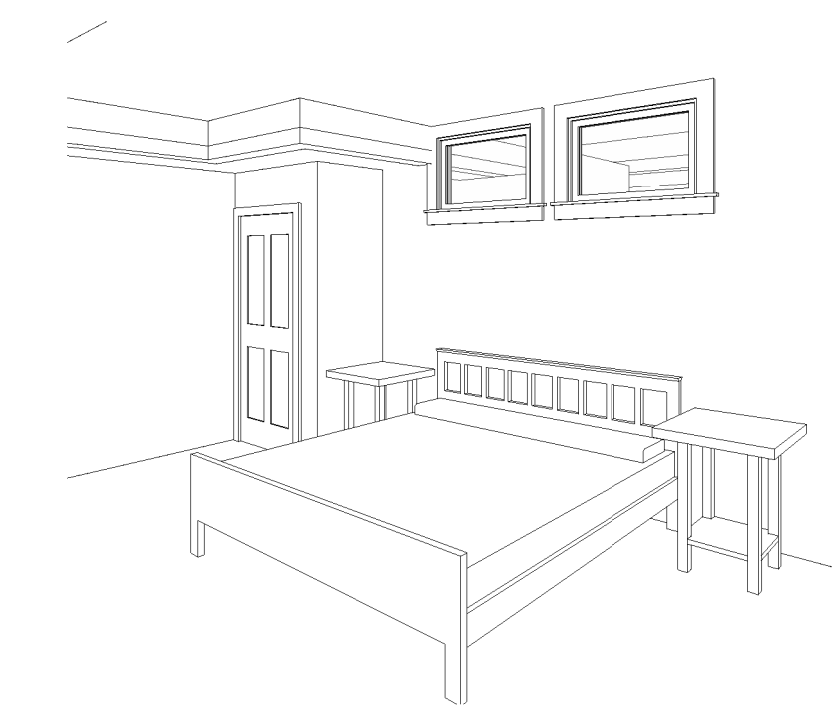


1 UPPER FLOOR  
A2 1/4" = 1'-0"

8/8/2008 10:38:52 AM

DATE: Issue Date

REVISIONS:

ISSUED FOR REVIEW  
2-14-08  
ISSUED FOR PERMIT  
3-31-08  
REVISED 4-20-08  
REVISED 5-5-08

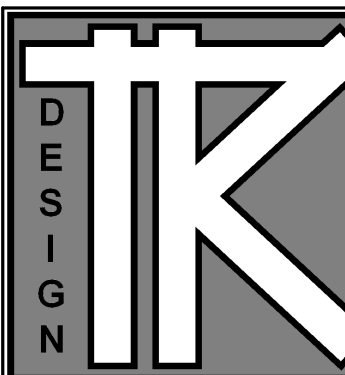

TODD KNUTSON  
DESIGN

530 NORTH 3RD ST.  
SUITE 530  
MINNEAPOLIS, MN. 55401  
PHONE 612-332-8000 X25  
FAX: 612-332-7504  
MOBIL: 612-251-1041

TERMS:  
CONTRACTOR TO VERIFY ALL DIMENSIONS, AS BUILT CONDITIONS (IF APPLY) AND SITE CONDITIONS, BEFORE ORDERING MATERIAL OR DEMOLISHING EXISTING STRUCTURES. CONTRACTOR AND ALL SUBS MUST REPORT ANY DISCREPANCIES TO DESIGNER IMMEDIATELY. AS BUILT AND SITE CONDITIONS OFTEN HAVE UNIQUE CONDITIONS THAT CANNOT BE PREDICTED OR FORSEEN AT DESIGN COMPLETION. CONTRACTOR, SUBS AND DESIGNER WILL WORK TOGETHER TO REACH A SOLUTION IF ANY SITUATION MAY ARISE.

KAHMEYER RESIDENCE

Enter address here


JOB NO: 2007

SHEET NO:

**A3**  
EXTERIOR  
ELEVATIONS



1 South  
AS 1/4" = 1'-0"

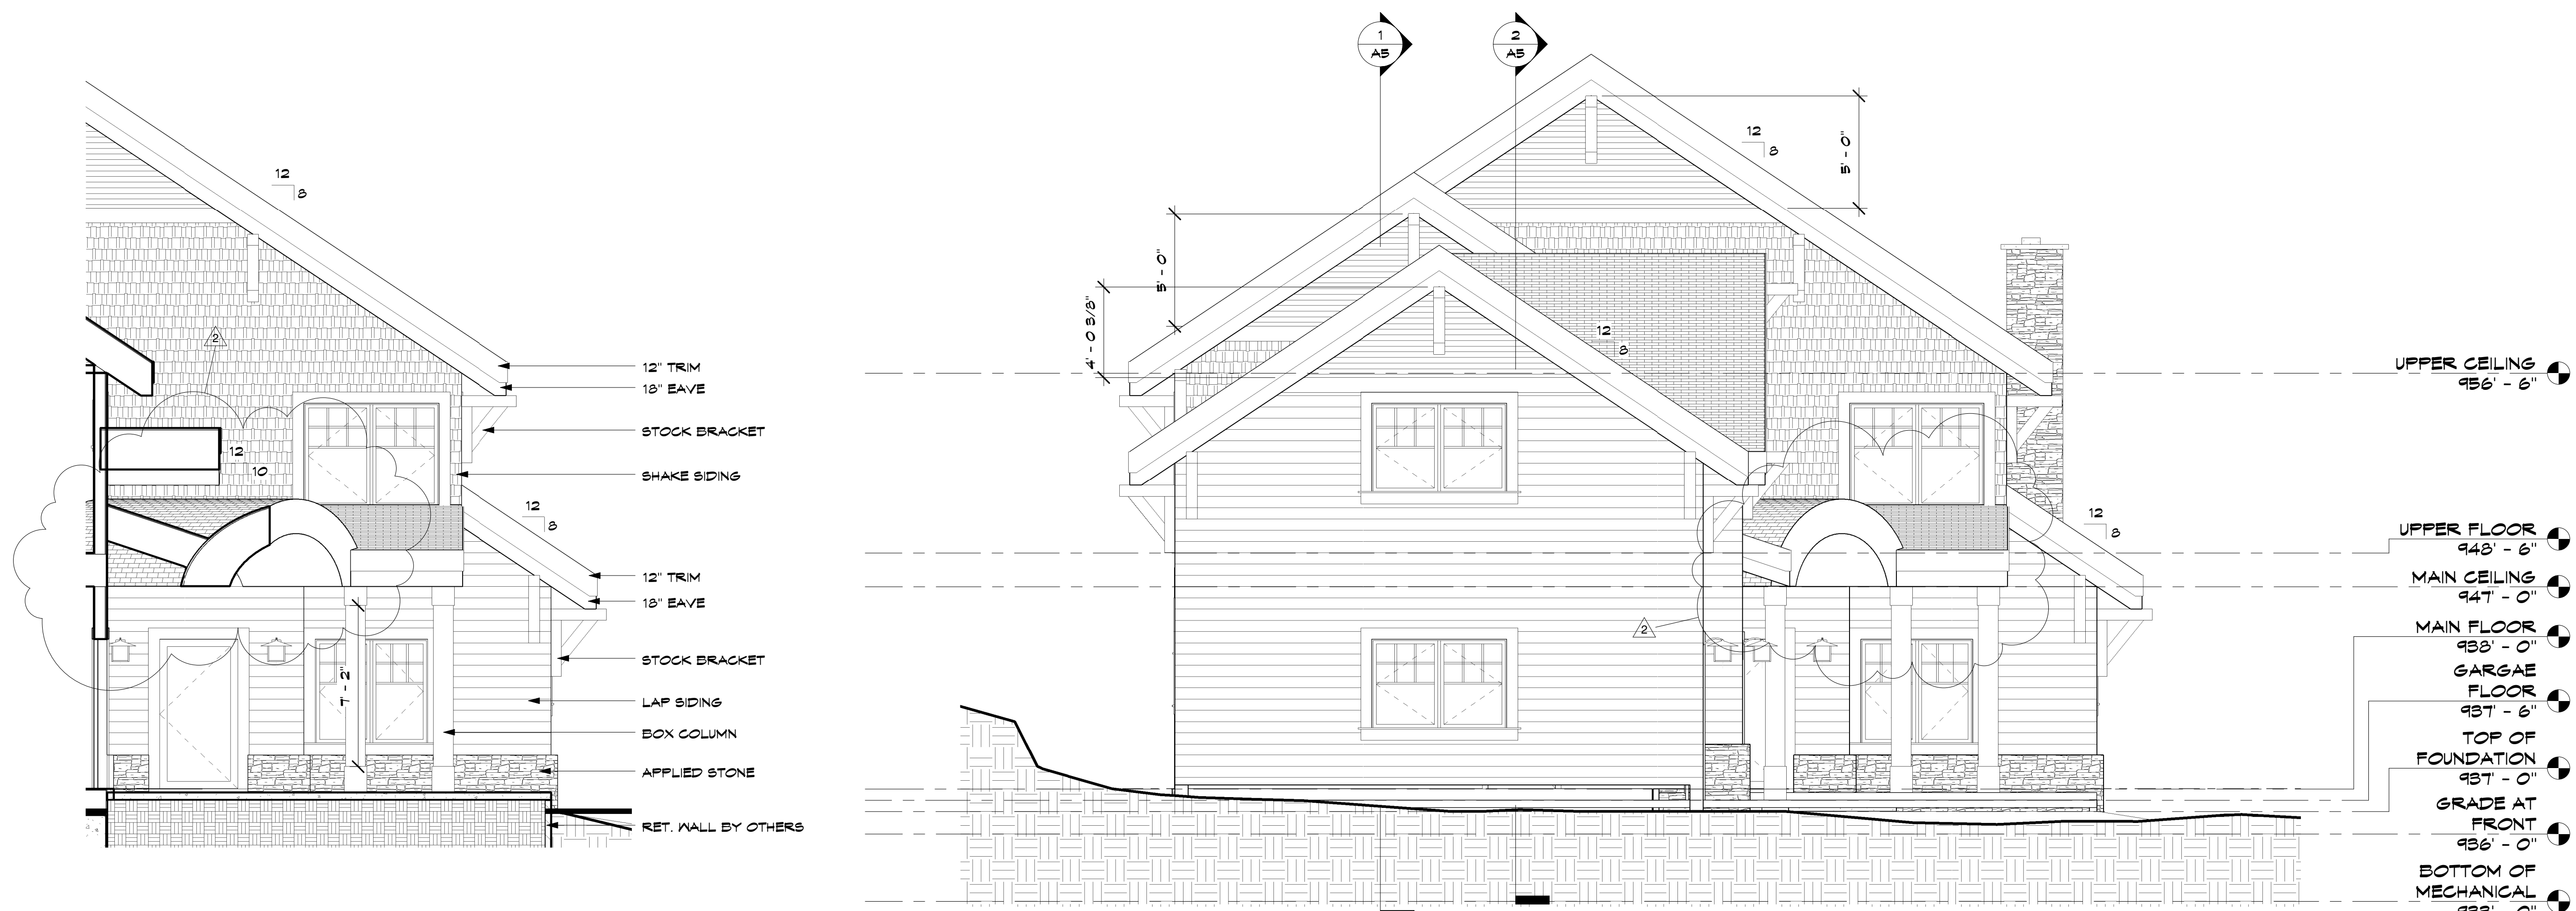


2 East  
AS 1/4" = 1'-0"

3 East Entry  
AS 1/4" = 1'-0"

DATE: Issue Date


REVISIONS:

ISSUED FOR REVIEW  
2-14-08  
ISSUED FOR PERMIT  
5-31-08  
REVISED 4-20-08  
REVISED 5-5-08

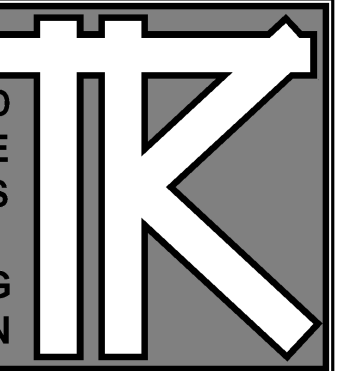


TODD KNUTSON  
DESIGN  
530 NORTH 3RD ST.  
SUITE 530  
MINNEAPOLIS, MN. 55401  
PHONE 612-332-8000 X25  
FAX: 612-332-7504  
MOBIL: 612-251-1041

TERMS:  
CONTRACTOR TO VERIFY ALL DIMENSIONS, AS BUILT CONDITIONS (IF APPLY) AND SITE CONDITIONS, BEFORE ORDERING MATERIAL OR DEMOLISHING EXISTING STRUCTURES. CONTRACTOR AND ALL SUBS MUST REPORT ANY DISCREPANCIES TO DESIGNER IMMEDIATELY. AS BUILT AND SITE CONDITIONS OFTEN HAVE UNIQUE CONDITIONS THAT CANNOT BE PREDICTED OR FORSEEN AT DESIGN COMPLETION. CONTRACTOR, SUBS AND DESIGNER WILL WORK TOGETHER TO REACH A SOLUTION IF ANY SITUATION MAY ARISE.

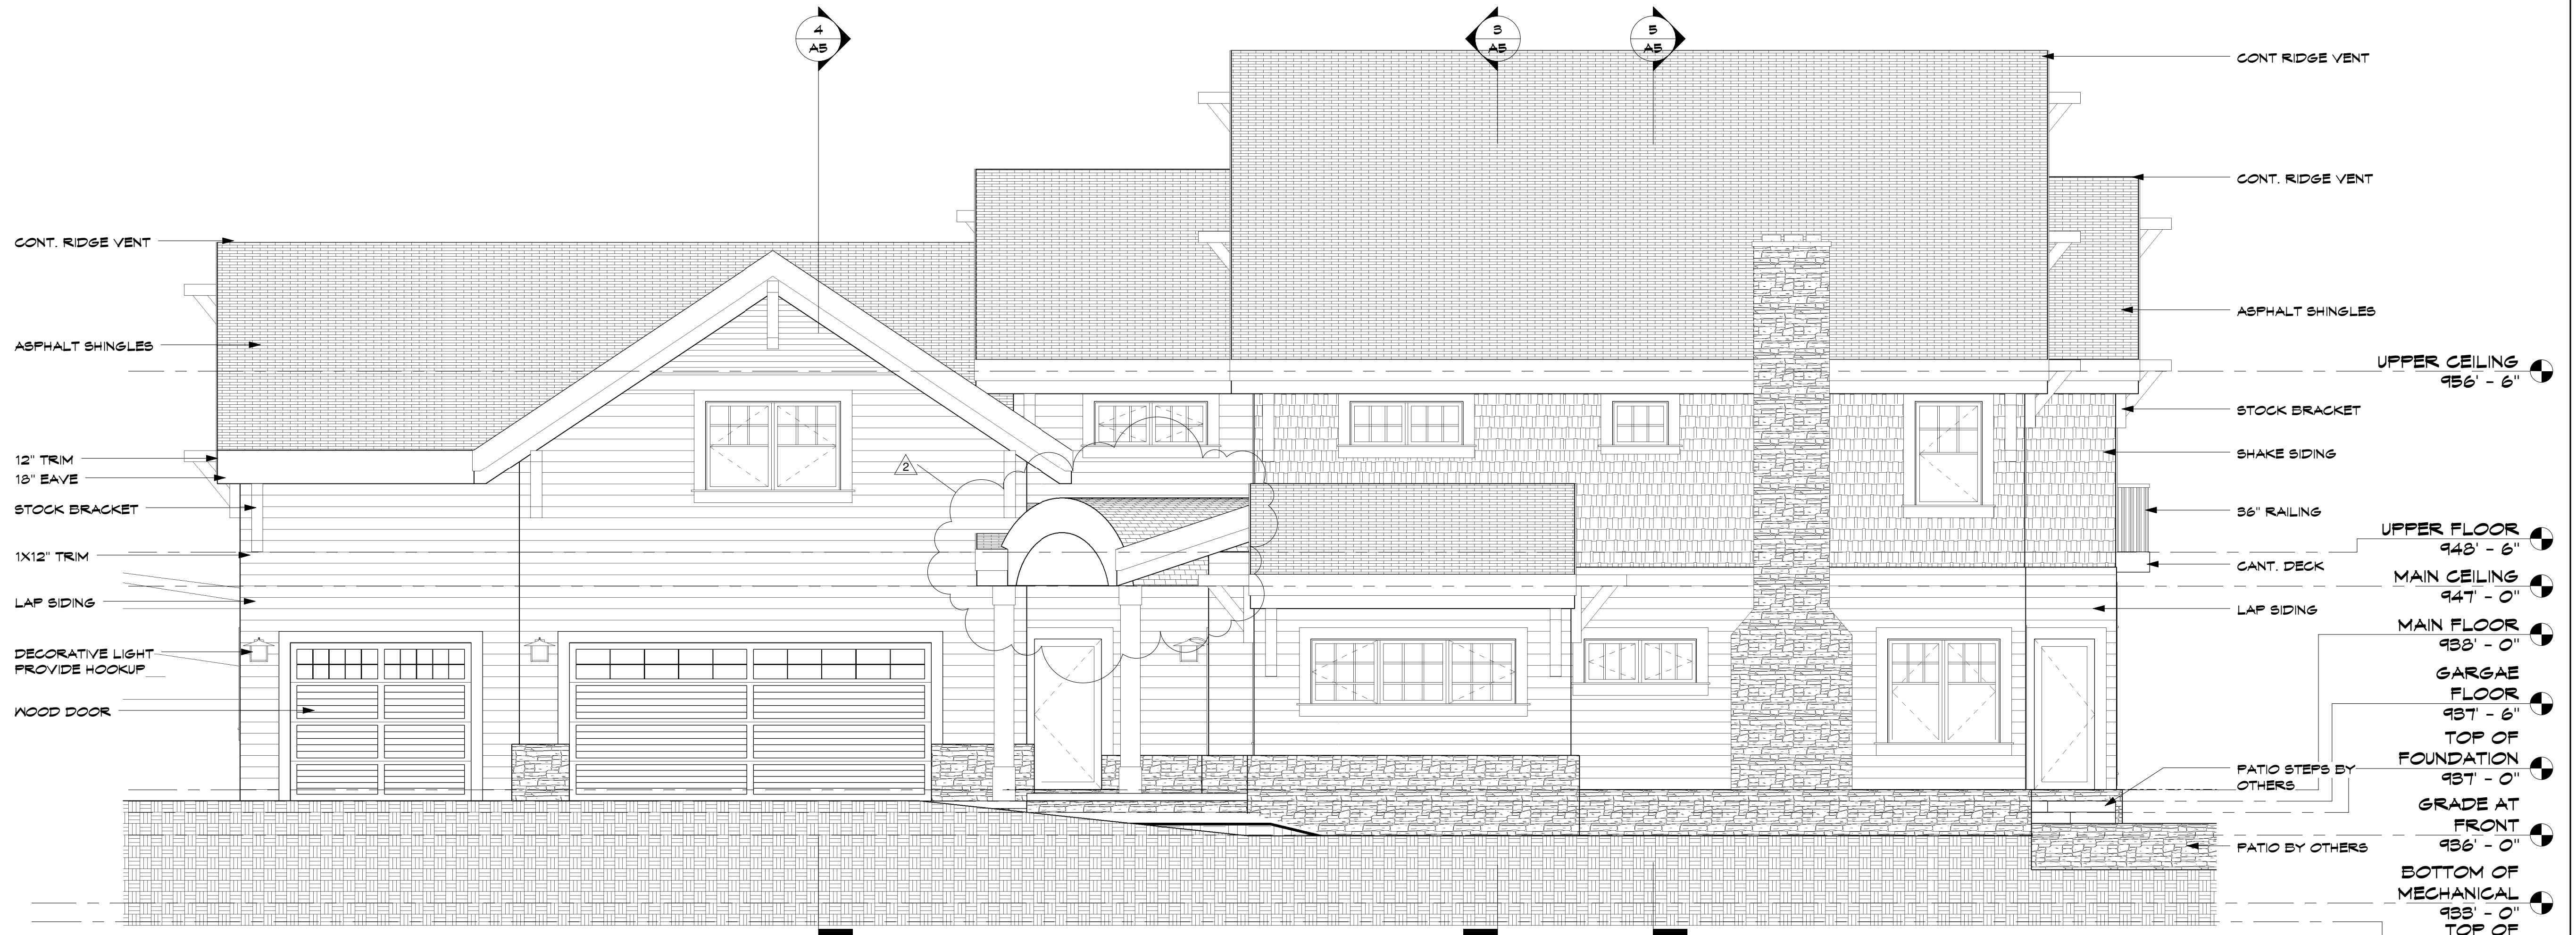

1 North  
A4 1/4" = 1'-0"

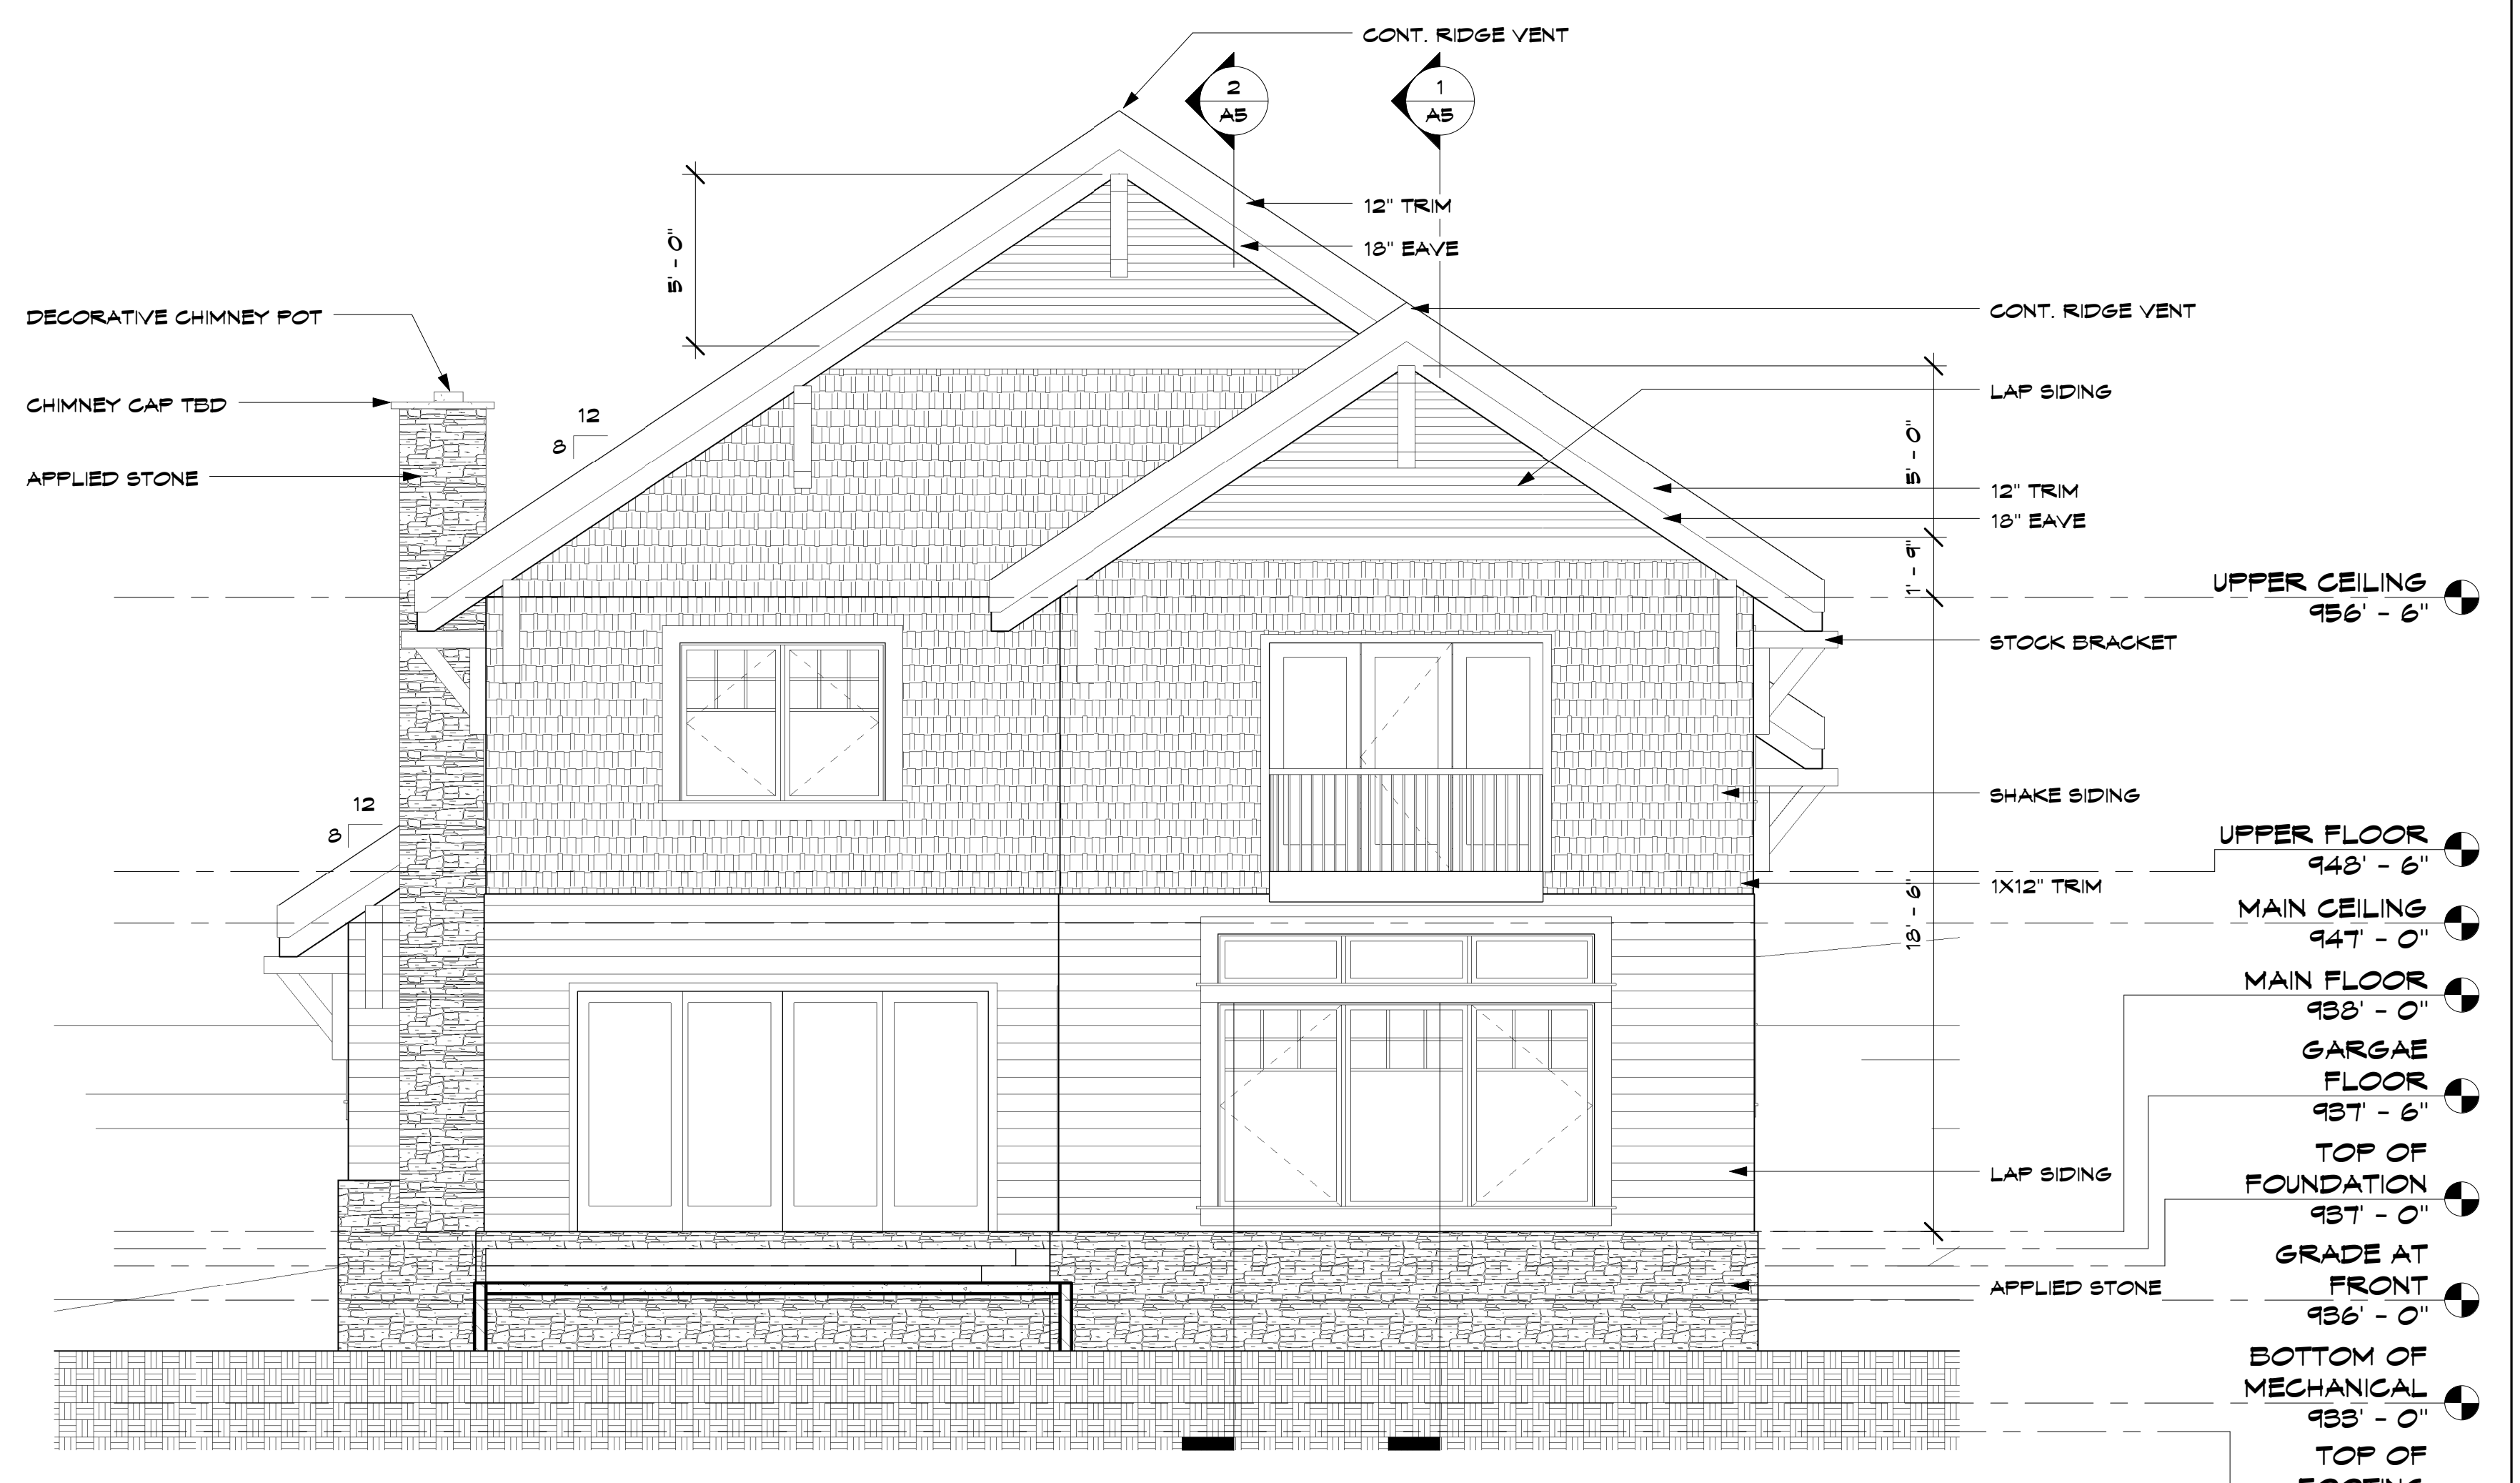

2 West  
A4 1/4" = 1'-0"

KAHMEYER RESIDENCE


Enter address here

JOB NO: 2007

SHEET NO:

A4

EXTERIOR ELEVATIONS

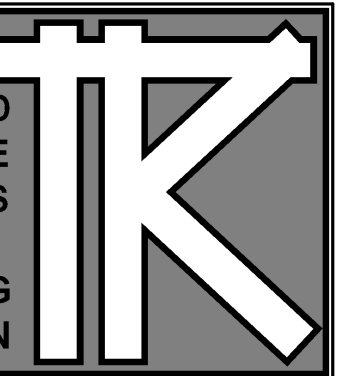

TODD KNUTSON  
DESIGN

530 NORTH 3RD ST.  
SUITE 530  
MINNEAPOLIS, MN. 55401  
PHONE 612-332-8000 X25  
FAX: 612-332-7504  
MOBIL: 612-251-1041

TERMS:

CONTRACTOR TO VERIFY ALL DIMENSIONS, AS BUILT CONDITIONS (IF APPLY) AND SITE CONDITIONS, BEFORE ORDERING MATERIAL OR DEMOLISHING EXISTING STRUCTURES. CONTRACTOR AND ALL SUBS MUST REPORT ANY DISCREPANCIES TO DESIGNER IMMEDIATELY. AS BUILT AND SITE CONDITIONS OFTEN HAVE UNIQUE CONDITIONS THAT CANNOT BE PREDICTED OR FORESEEN AT DESIGN COMPLETION. CONTRACTOR, SUBS AND DESIGNER WILL WORK TOGETHER TO REACH A SOLUTION IF ANY SITUATION MAY ARISE.

KAHMEYER RESIDENCE



Enter address here

JOB NO: 2007


SHEET NO:

**A5**


SECTIONS

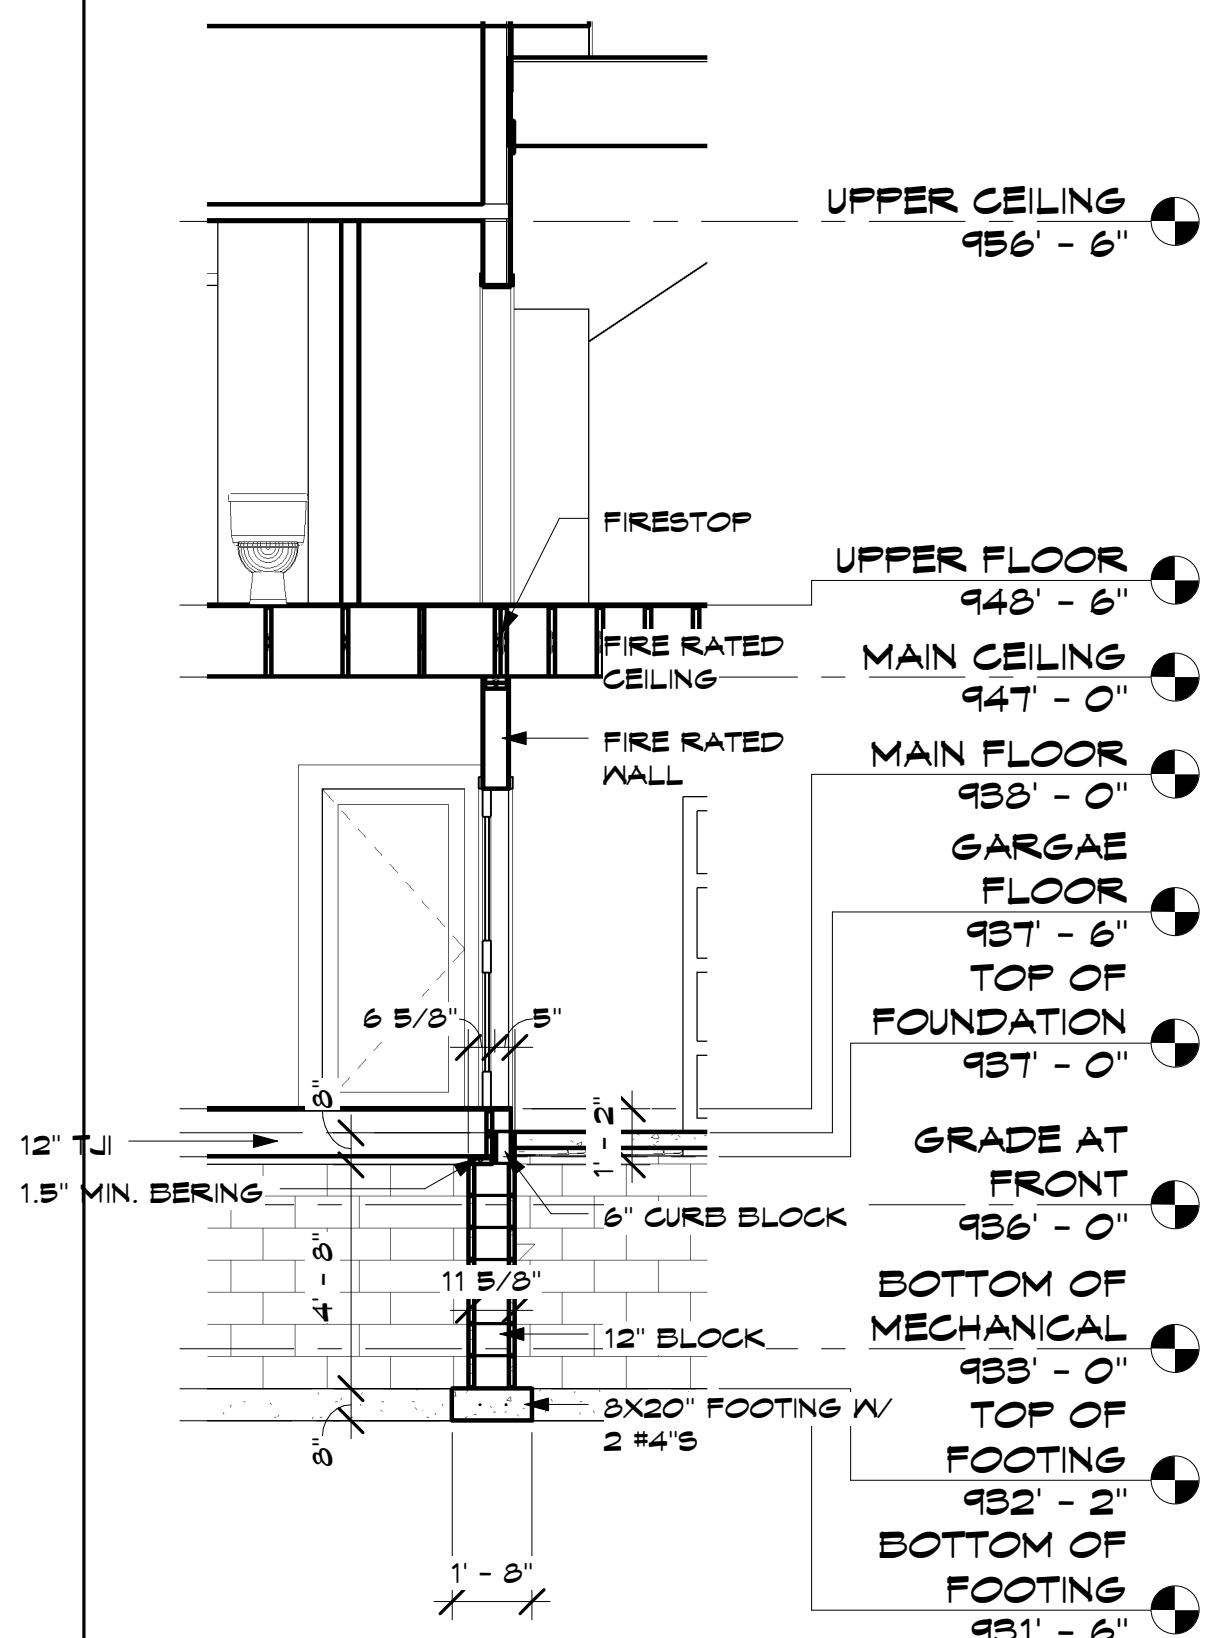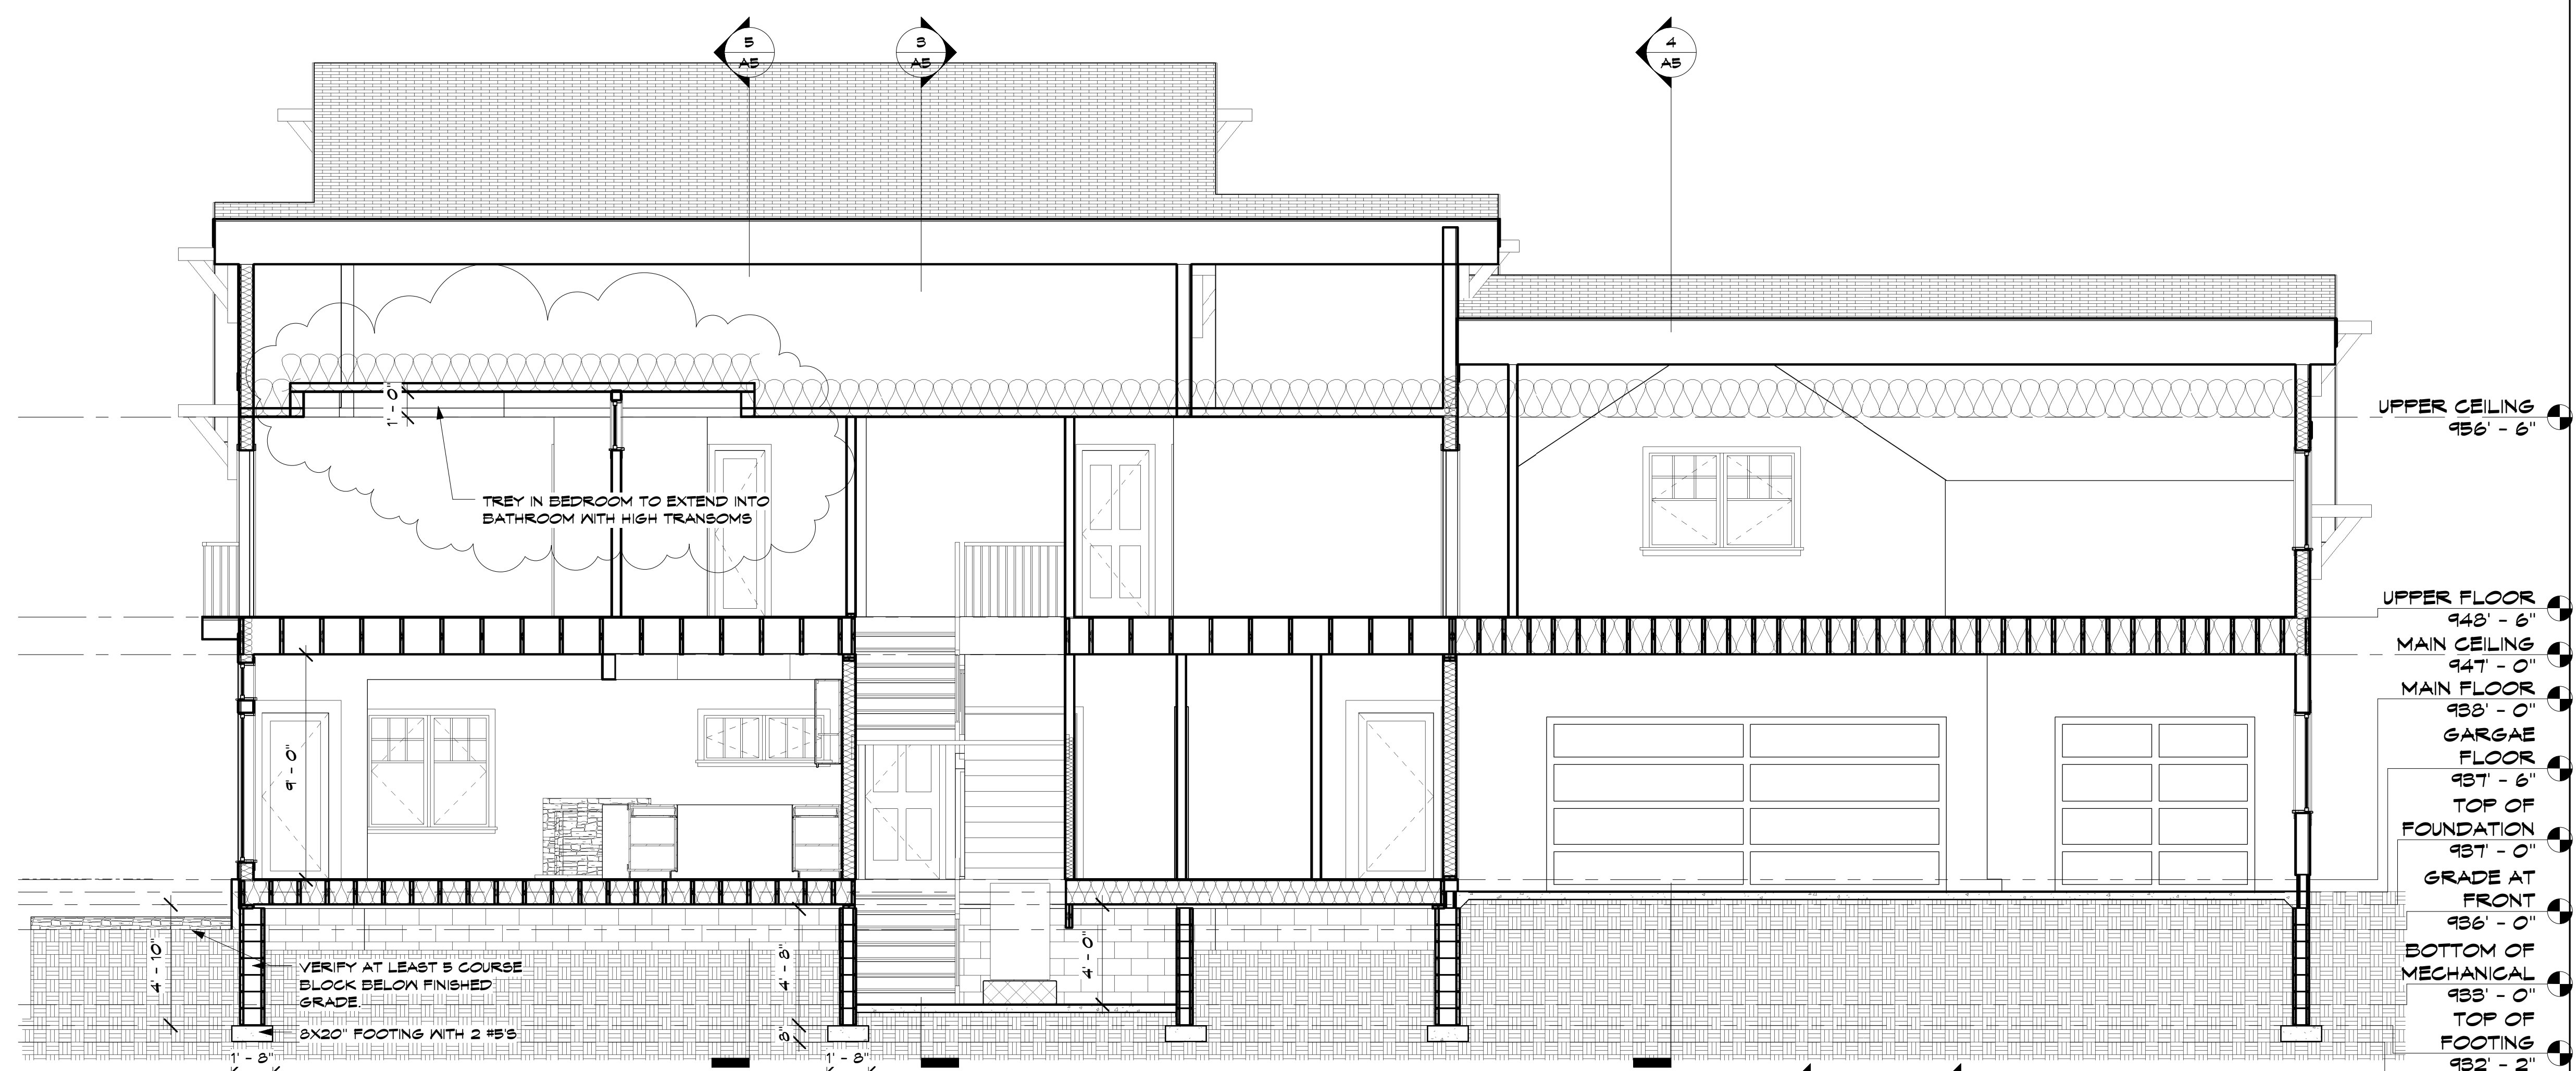


2 WALL DETAIL @ HOUSE  
1/4" = 1'-0"

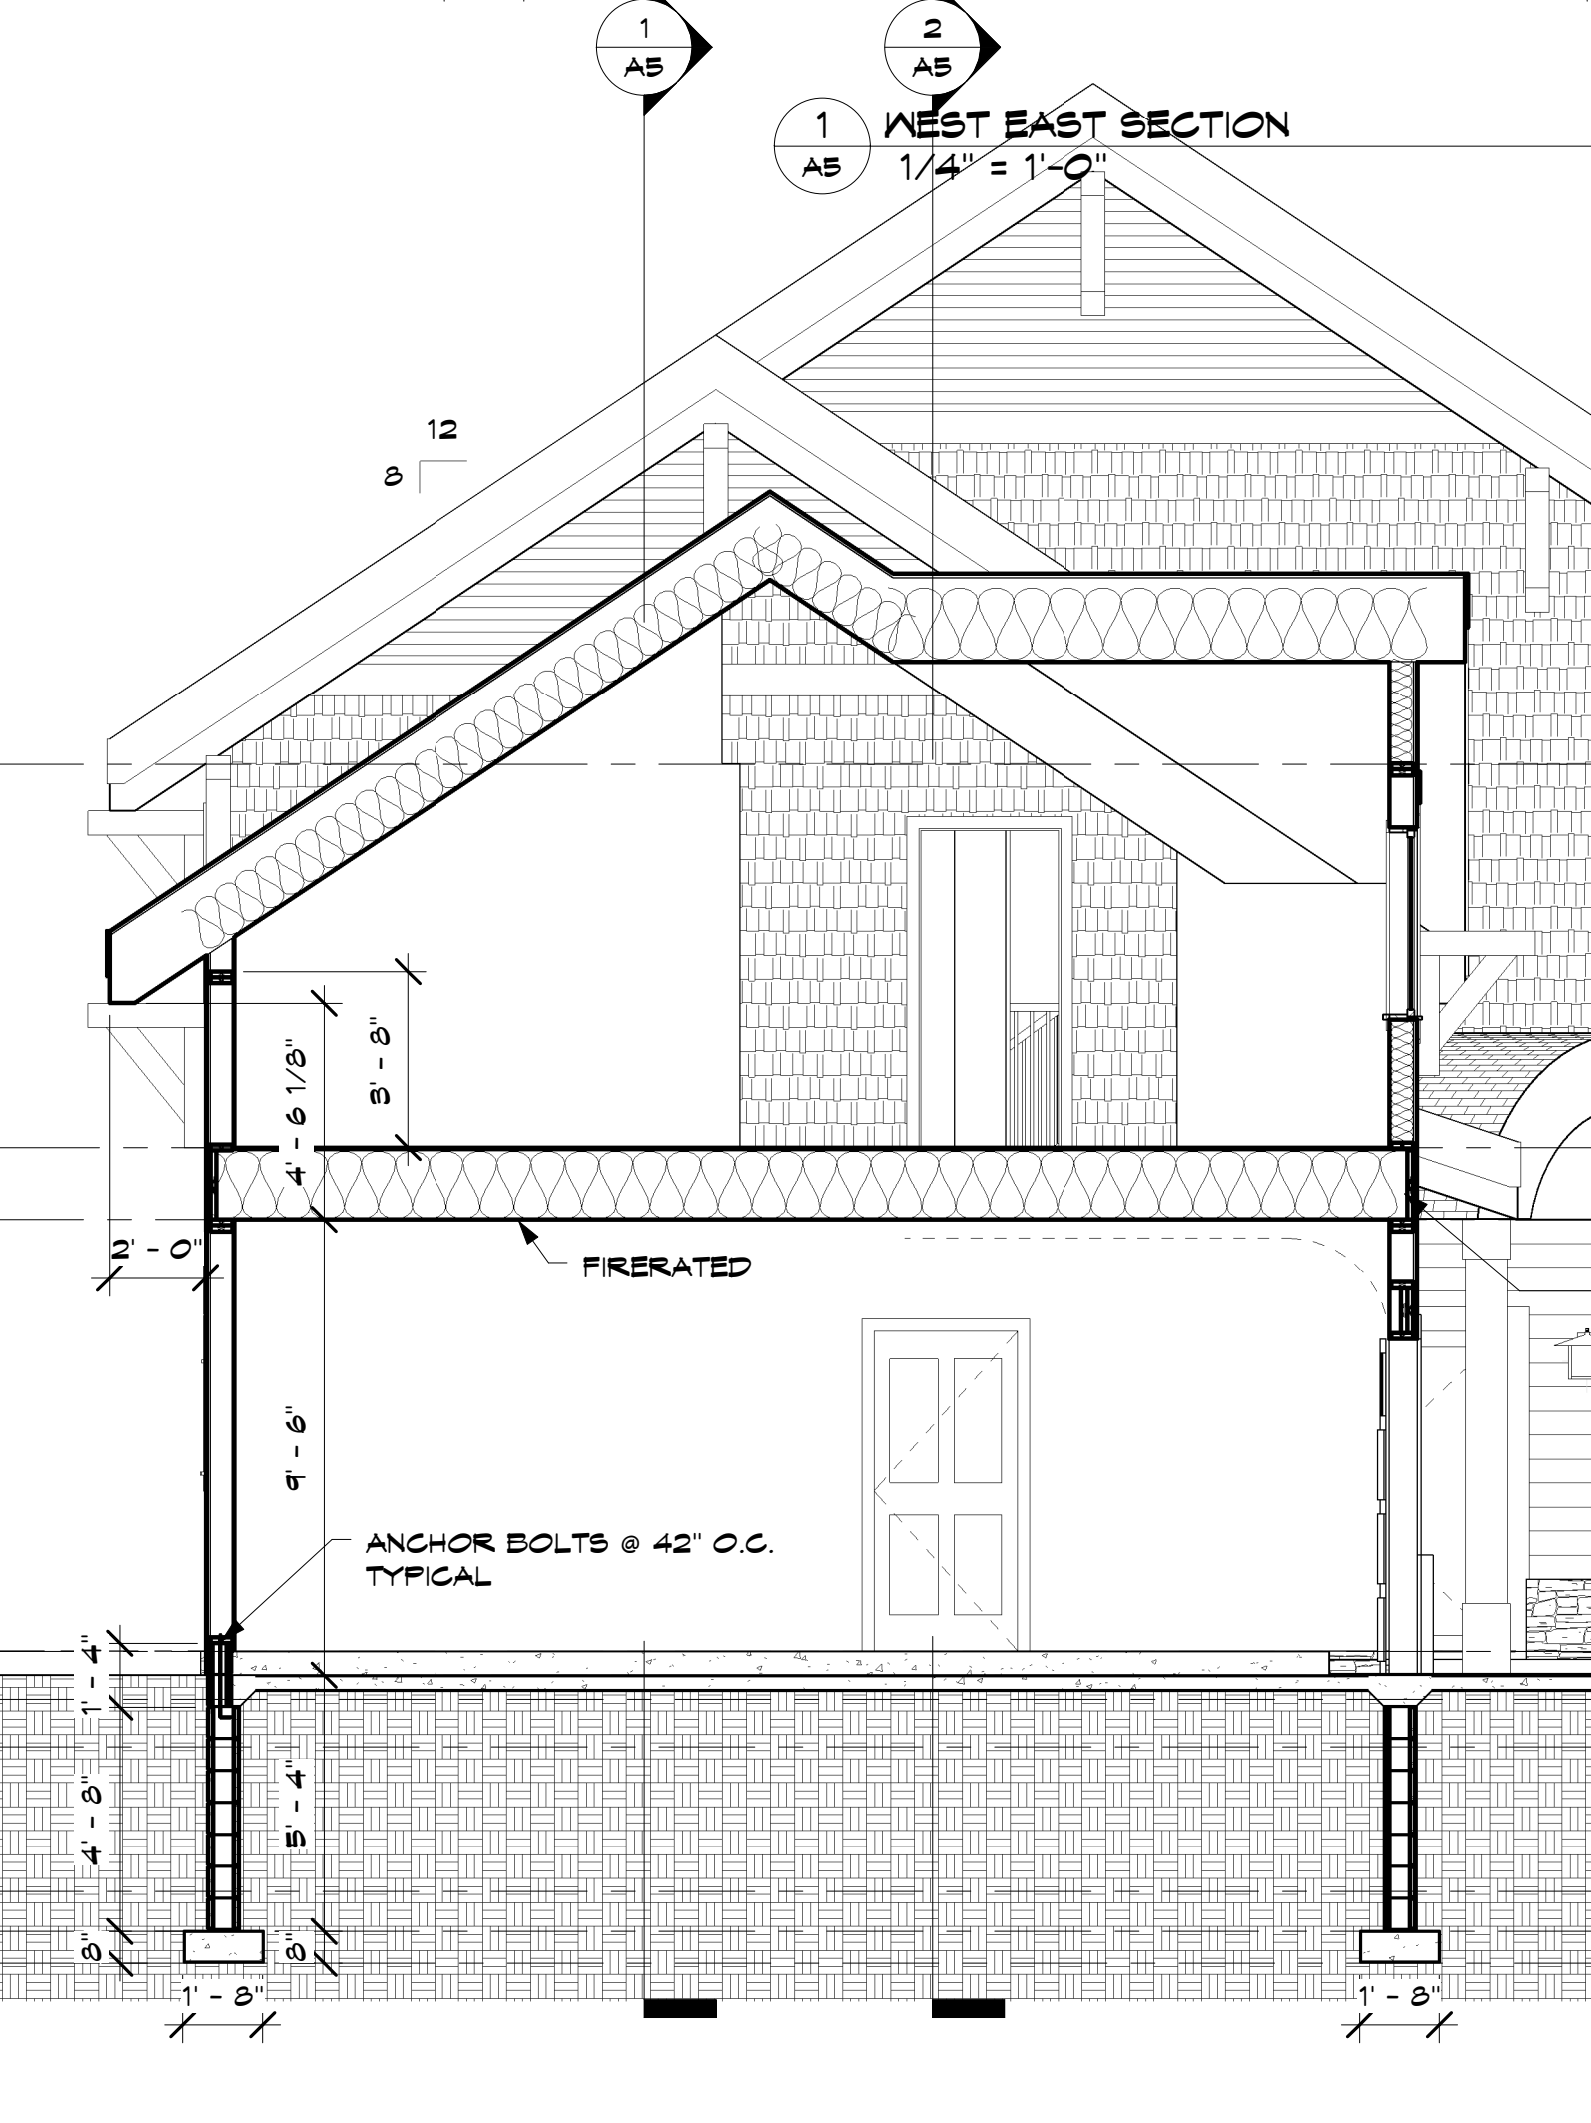

4 SECTION AT GARAGE DORMER  
1/4" = 1'-0"

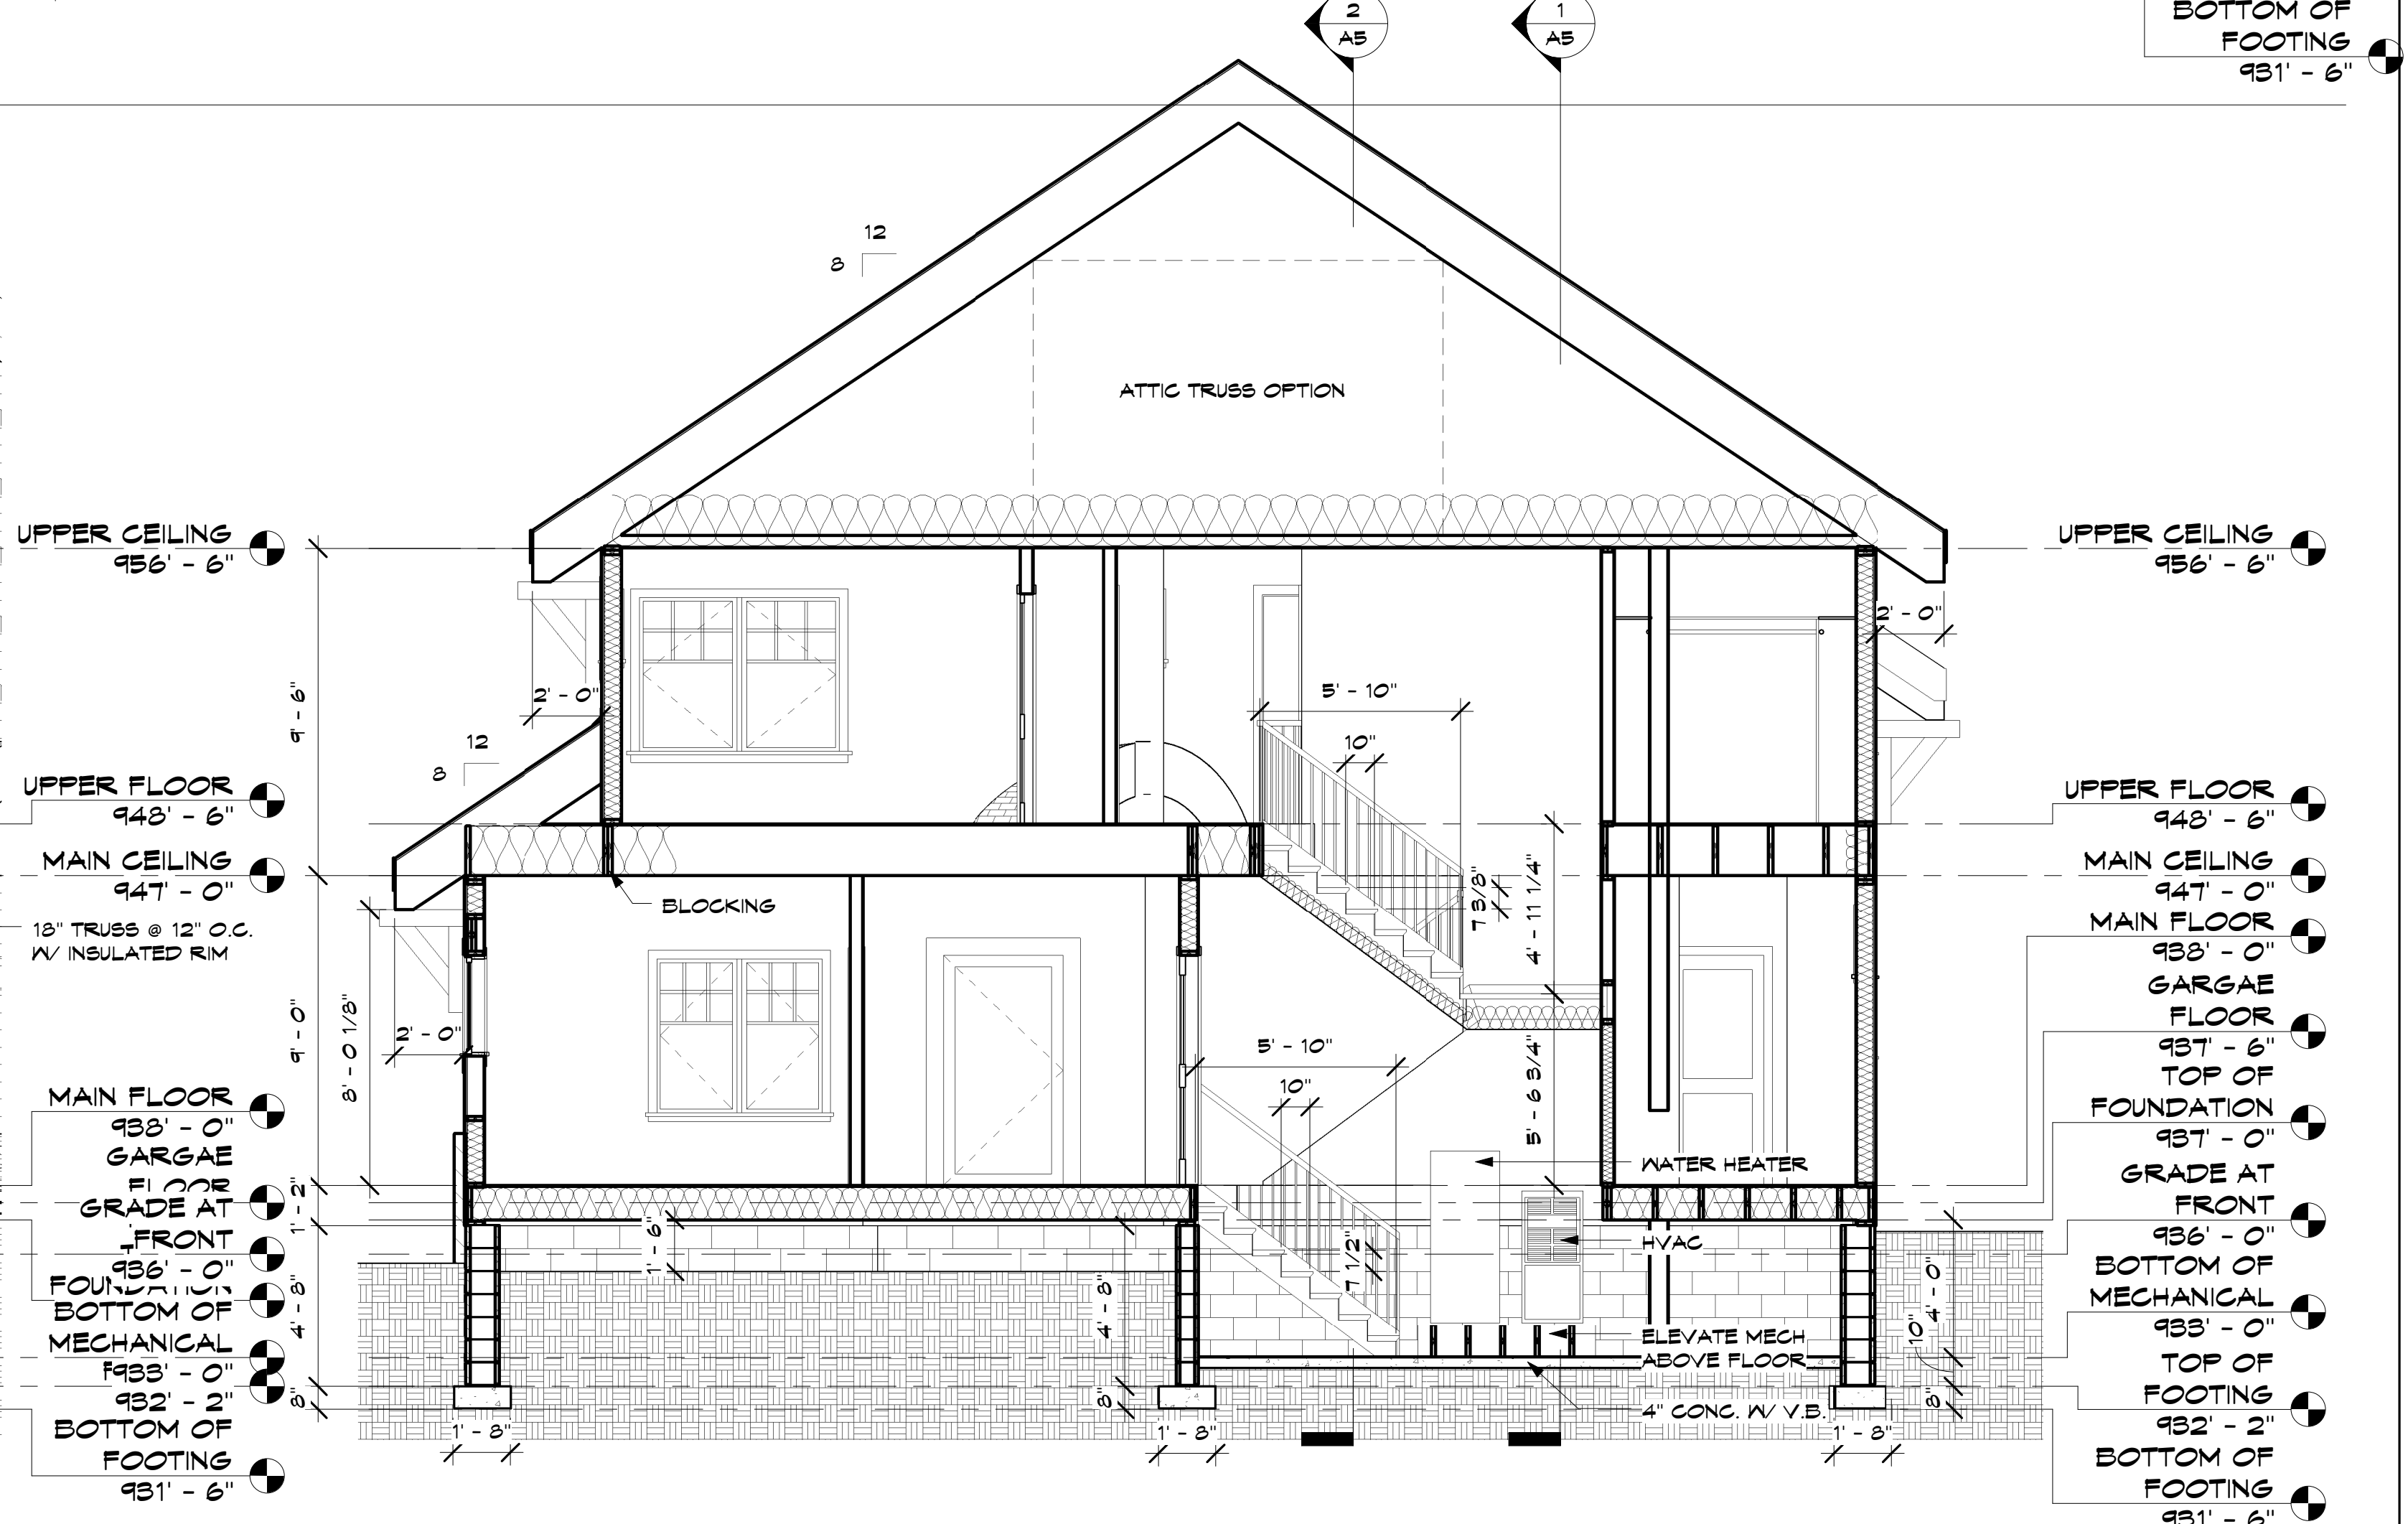

3 SECTION @ N.S. MECHANICAL STAIR  
1/4" = 1'-0"

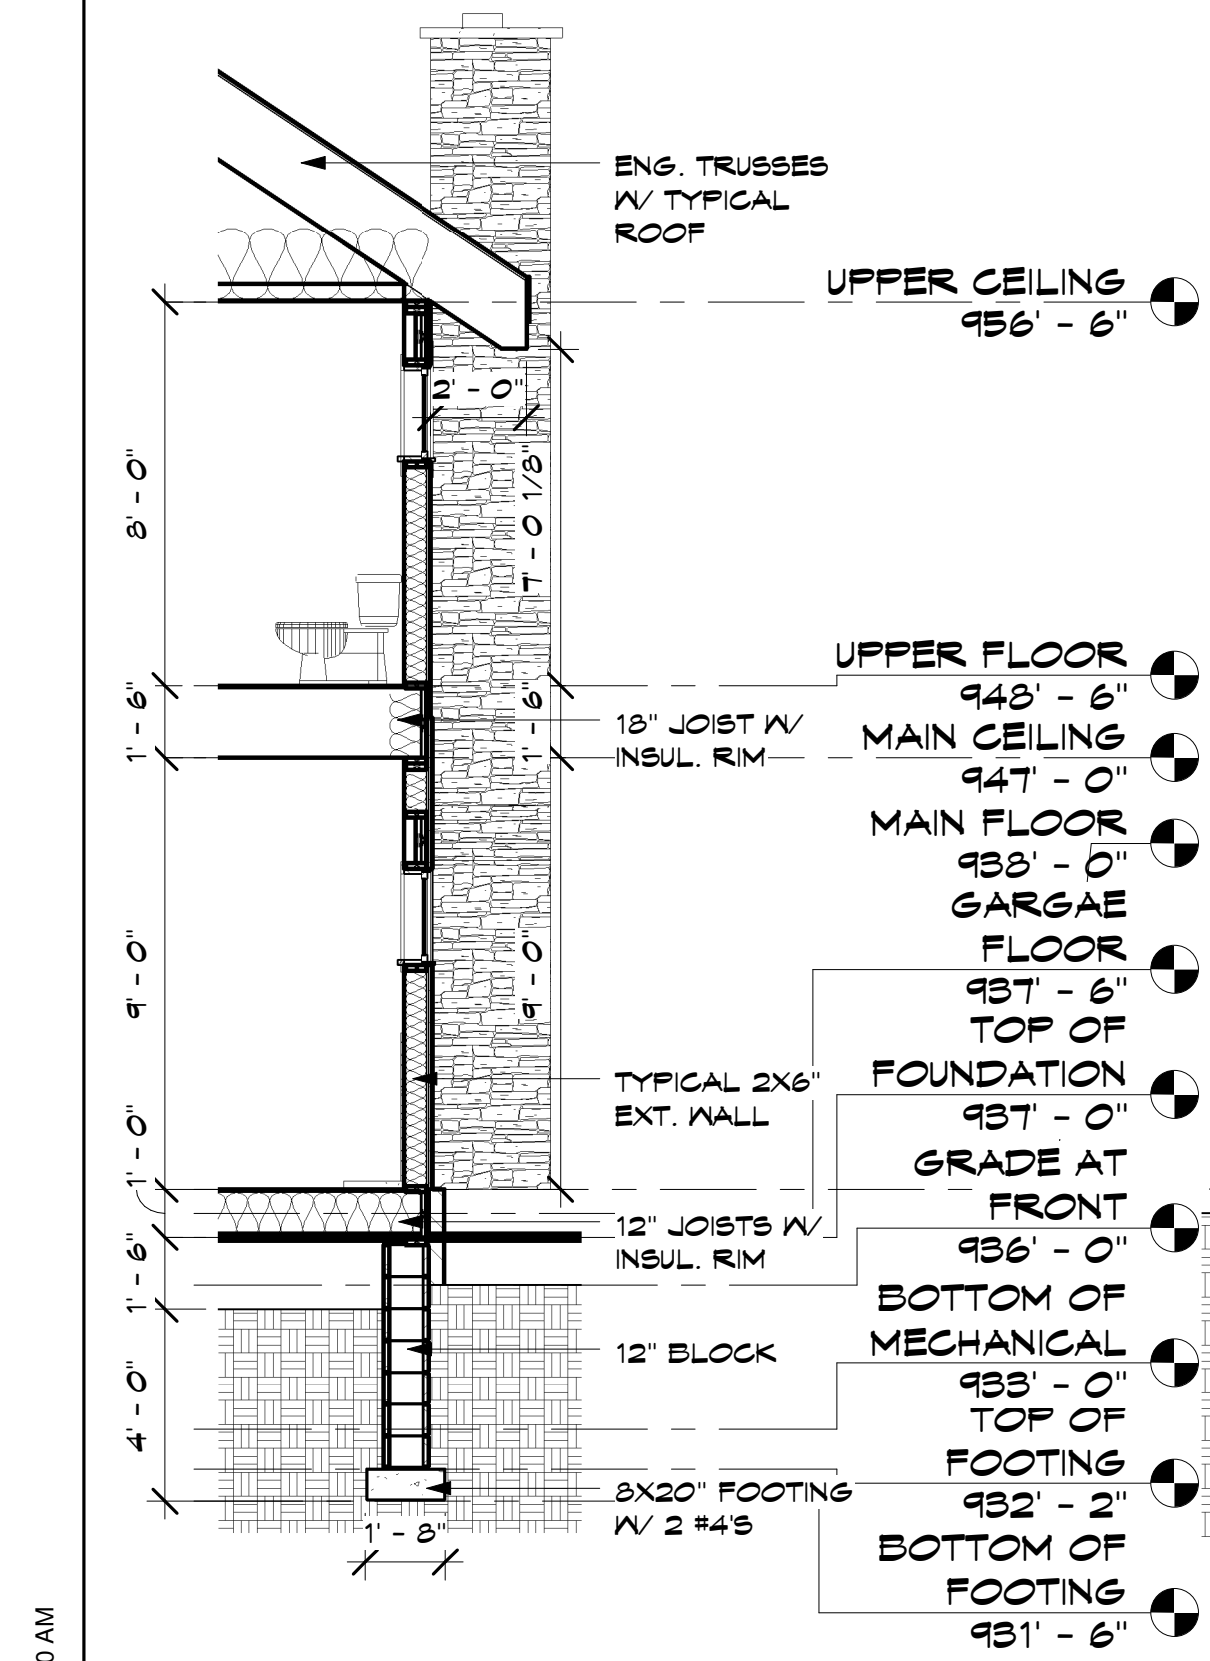

5 WALL DETAIL  
1/4" = 1'-0"

# KAHMEYER RESIDENCE

Drawing List		
Sheet #	Sheet Name	SHEET ORDER
A0	FOOTING PLAN	
A5	SECTIONS	
T	TITLE PAGE	1
A1	FLOOR PLAN	5
A2	FLOOR PLAN	6
A3	EXTERIOR ELEVATIONS	7
A4	EXTERIOR ELEVATIONS	8

DATE: Issue Date

REVISIONS:

ISSUED FOR REVIEW  
2-14-08  
ISSUED FOR PERMIT  
3-31-08  
REVISED 4-20-08  
REVISED 5-5-08



TODD KNUTSON  
DESIGN

530 NORTH 3RD ST.  
SUITE 530  
MINNEAPOLIS, MN. 55401  
PHONE: 612-332-8000 X25  
FAX: 612-332-7504  
MOBIL: 612-251-1041

TERMS:


CONTRACTOR TO VERIFY ALL DIMENSIONS, AS BUILT CONDITIONS (IF APPLY) AND SITE CONDITIONS, BEFORE ORDERING MATERIAL OR DEMOLISHING EXISTING STRUCTURES. CONTRACTOR AND ALL SUBS MUST REPORT ANY DISCREPANCIES TO DESIGNER IMMEDIATELY. AS BUILT AND SITE CONDITIONS OFTEN HAVE UNIQUE CONDITIONS THAT CANNOT BE PREDICTED OR FORSEEN AT DESIGN COMPLETION. CONTRACTOR, SUBS AND DESIGNER WILL WORK TOGETHER TO REACH A SOLUTION IF ANY SITUATION MAY ARISE.



2 SD View 1



3 SD View 10

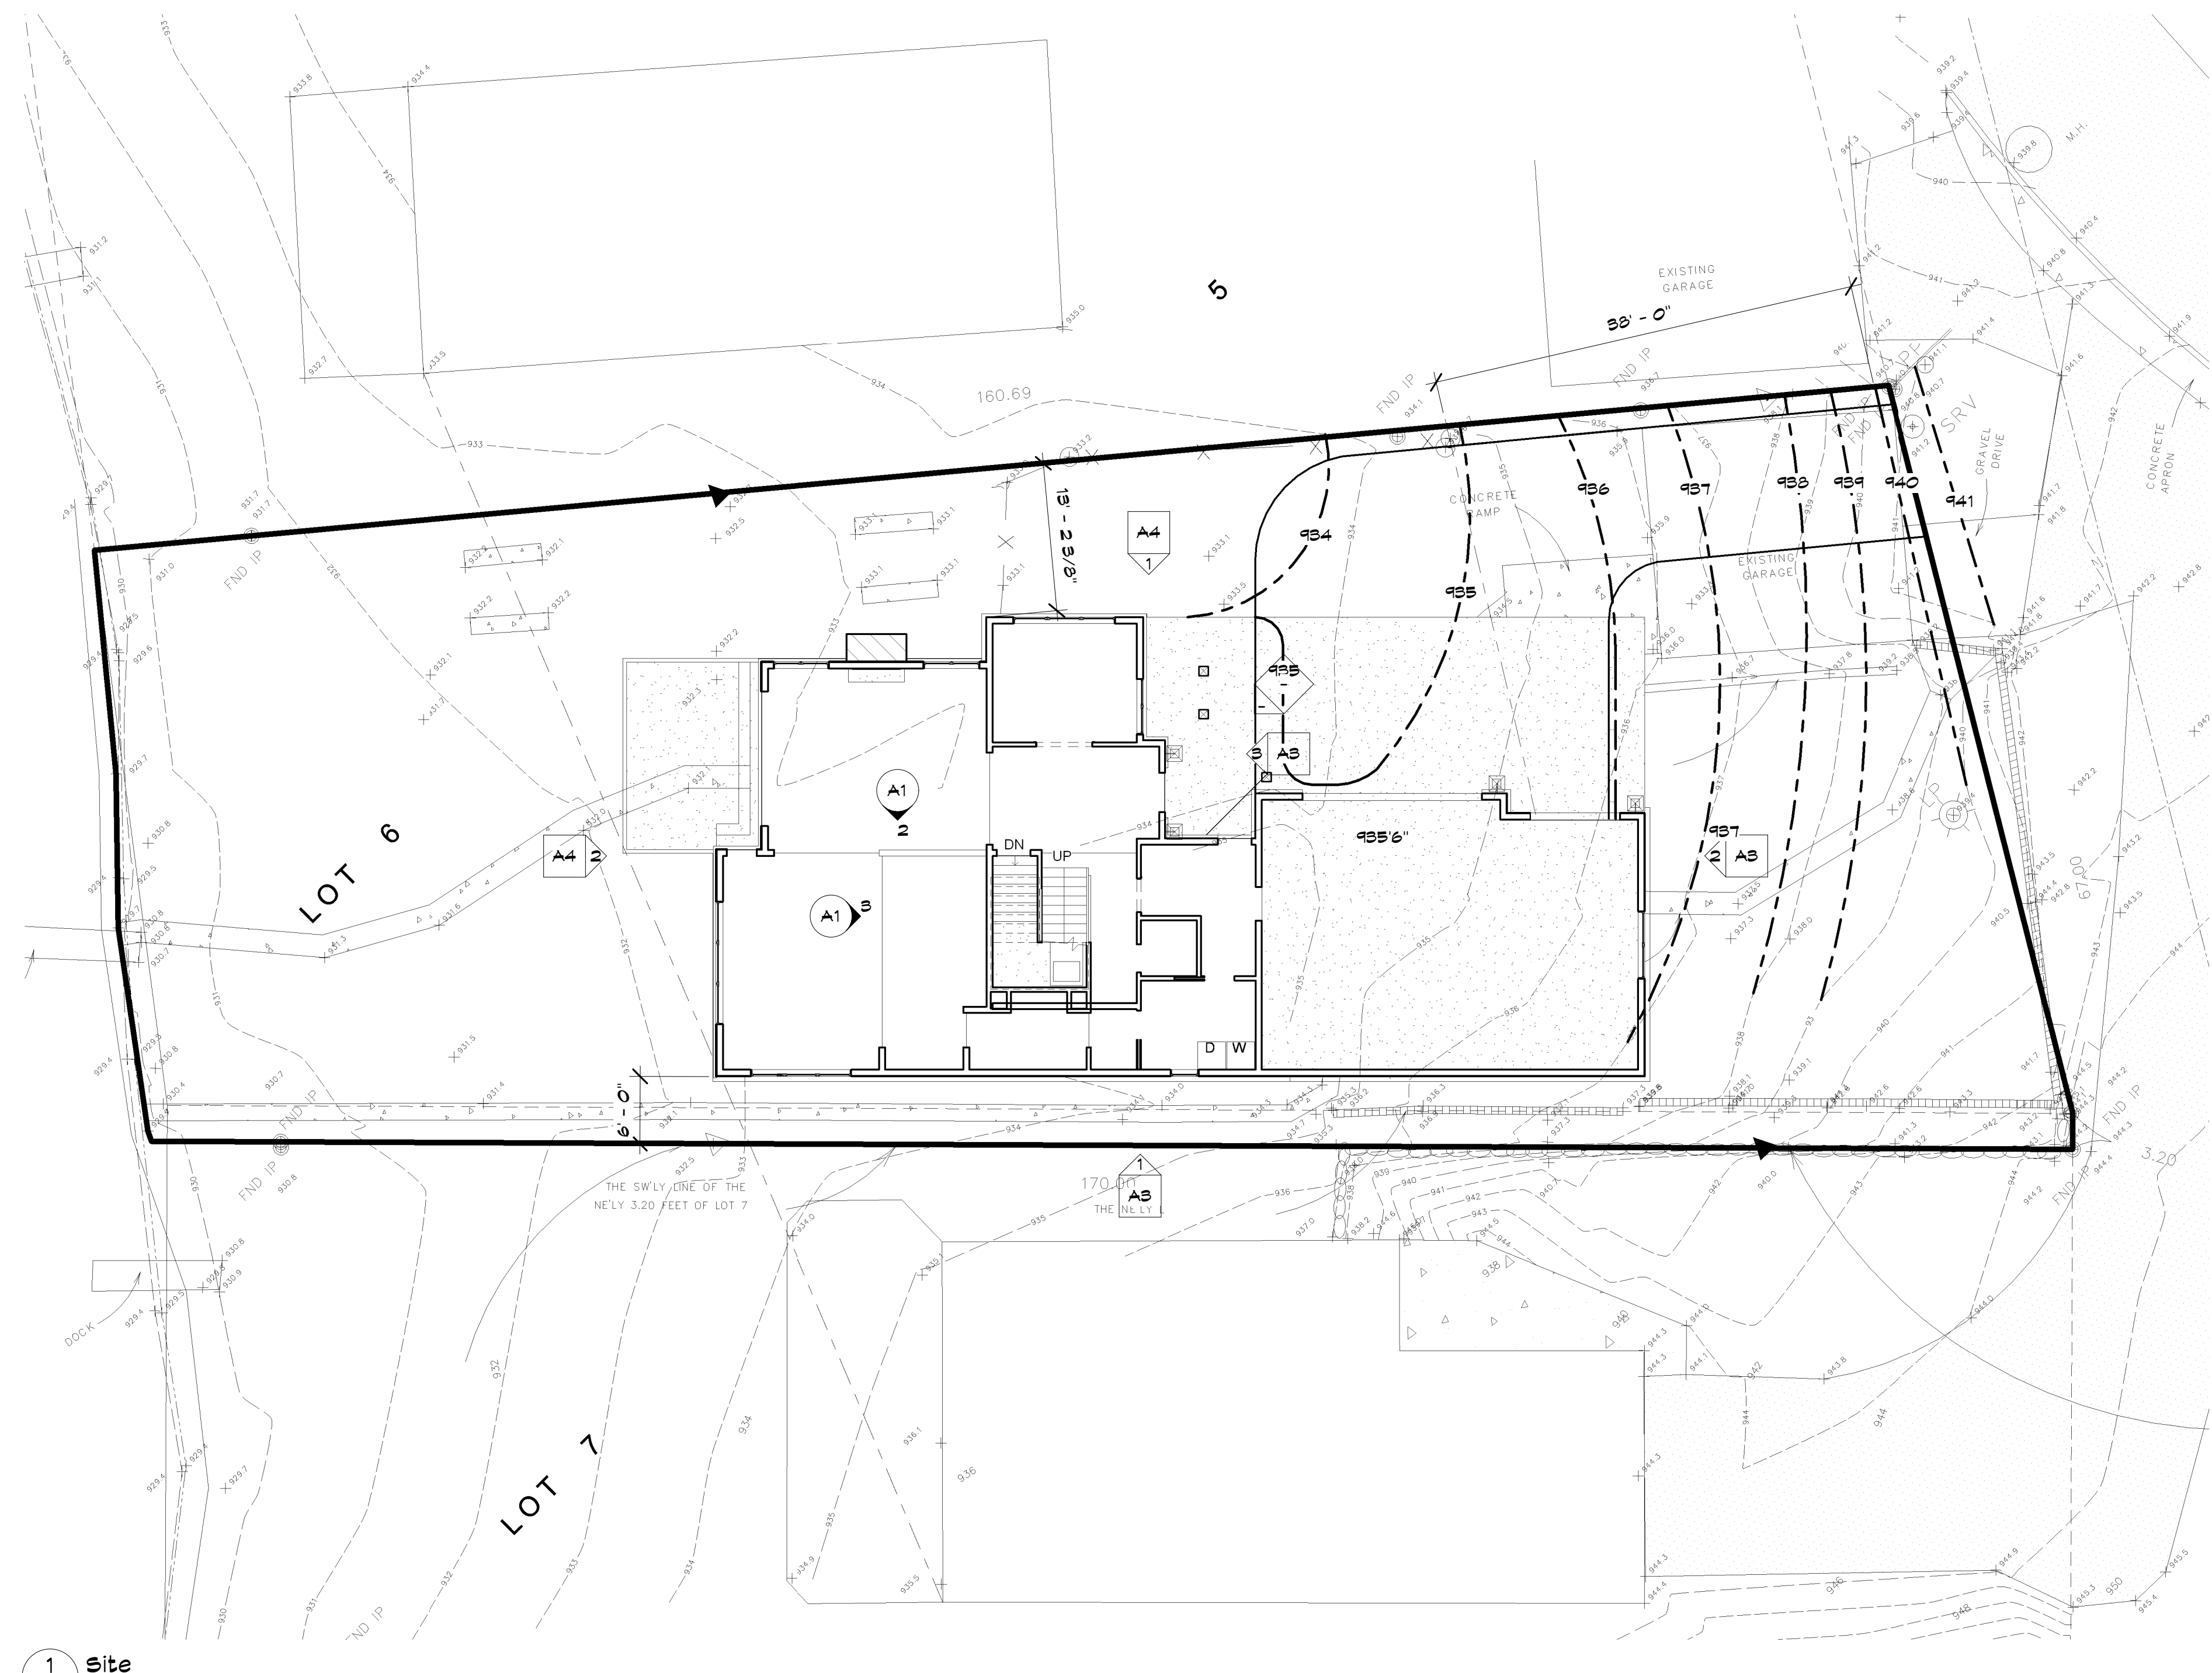

1 Site  
1" = 10'-0"

KAHMEYER RESIDENCE

Enter address here

JOB NO: 2007

SHEET NO:

T

TITLE PAGE