


DATE: Issue Date

REVISIONS:

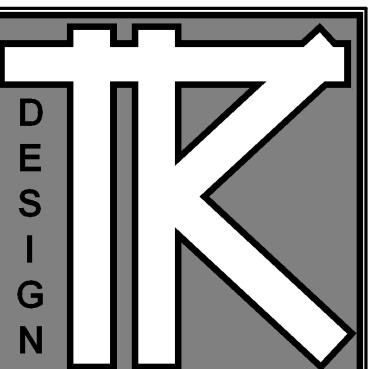

TODD KNUSTON DESIGN
2388 UNIVERSITY AV. W.
STUDIO 100
SAINT PAUL, MN. 55114
PHONE: 651-472-0054
FAX: 651-472-0060
MOBIL: 612-251-1041


PROJECT NAME

JOB NO: 08XX


SHEET NO:

E1


MAIN FLOOR

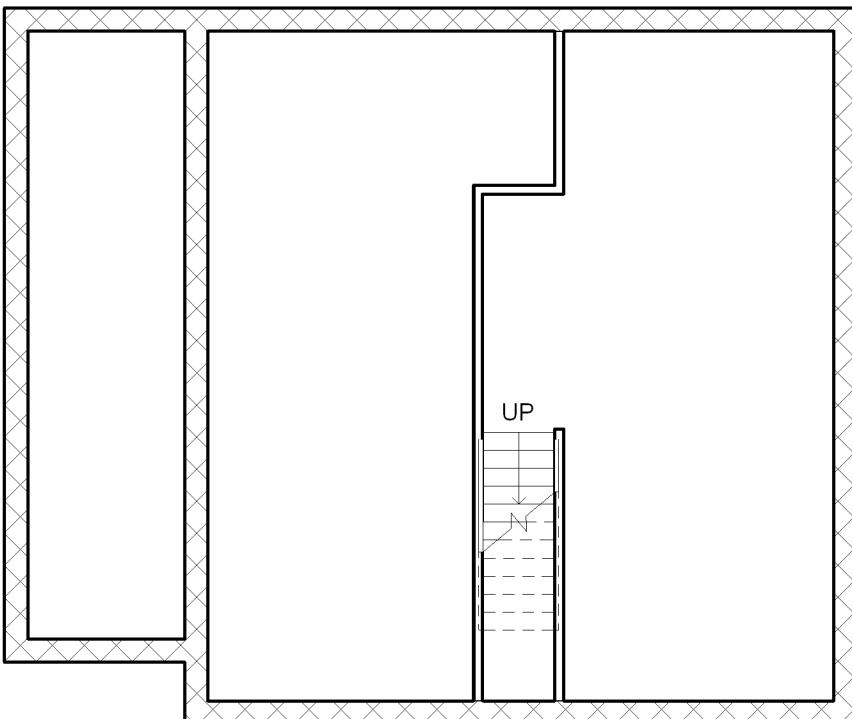

1 LOWER FLOOR
E1
1/8" = 1'-0"

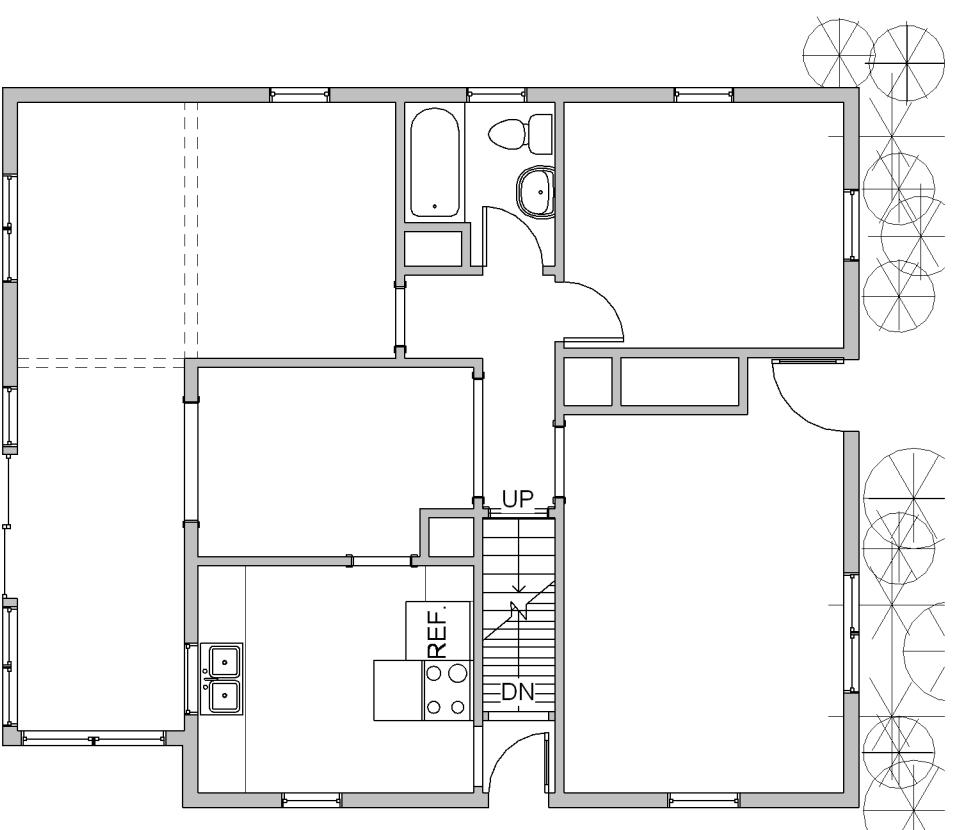

2 MAIN FLOOR
E1
1/8" = 1'-0"

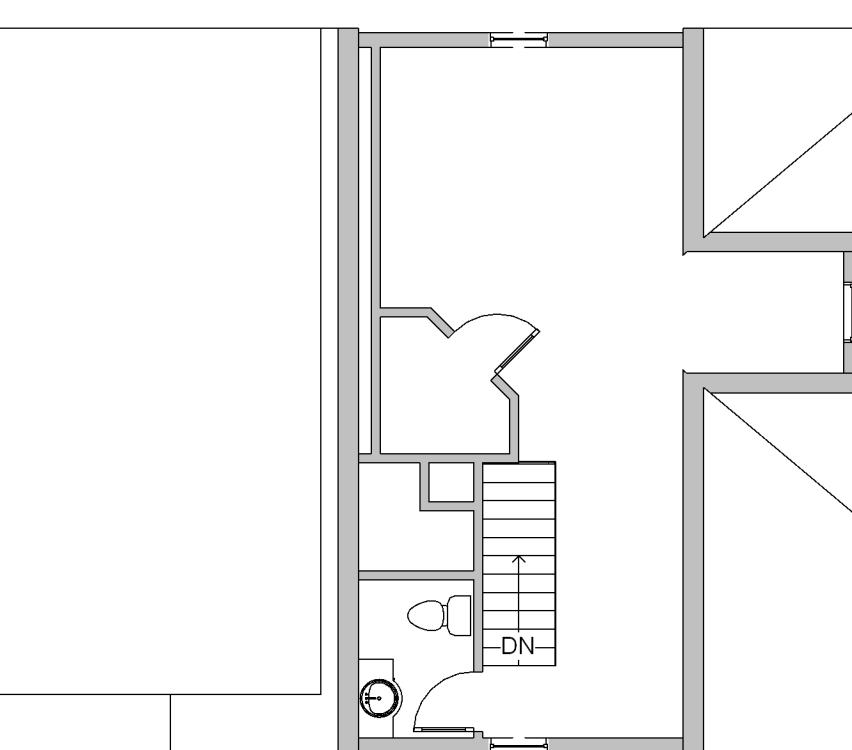

3 2ND FLOOR
E1
1/8" = 1'-0"



4 EAST
E1
1/4" = 1'-0"



5 NORTH
E1
1/8" = 1'-0"



6 WEST
E1
1/8" = 1'-0"



7 SOUTH
E1
1/8" = 1'-0"